


Sketch Number - Option B Upper level Mark-ups

Gensler

Project	Little St. James	Project Number	05.7112.000
Description	Main Residence Level - Option A	Issue/Rev	Issue for Review
Prepared by	Scale	Date	December 14, 2010

1/16"=1'-0"

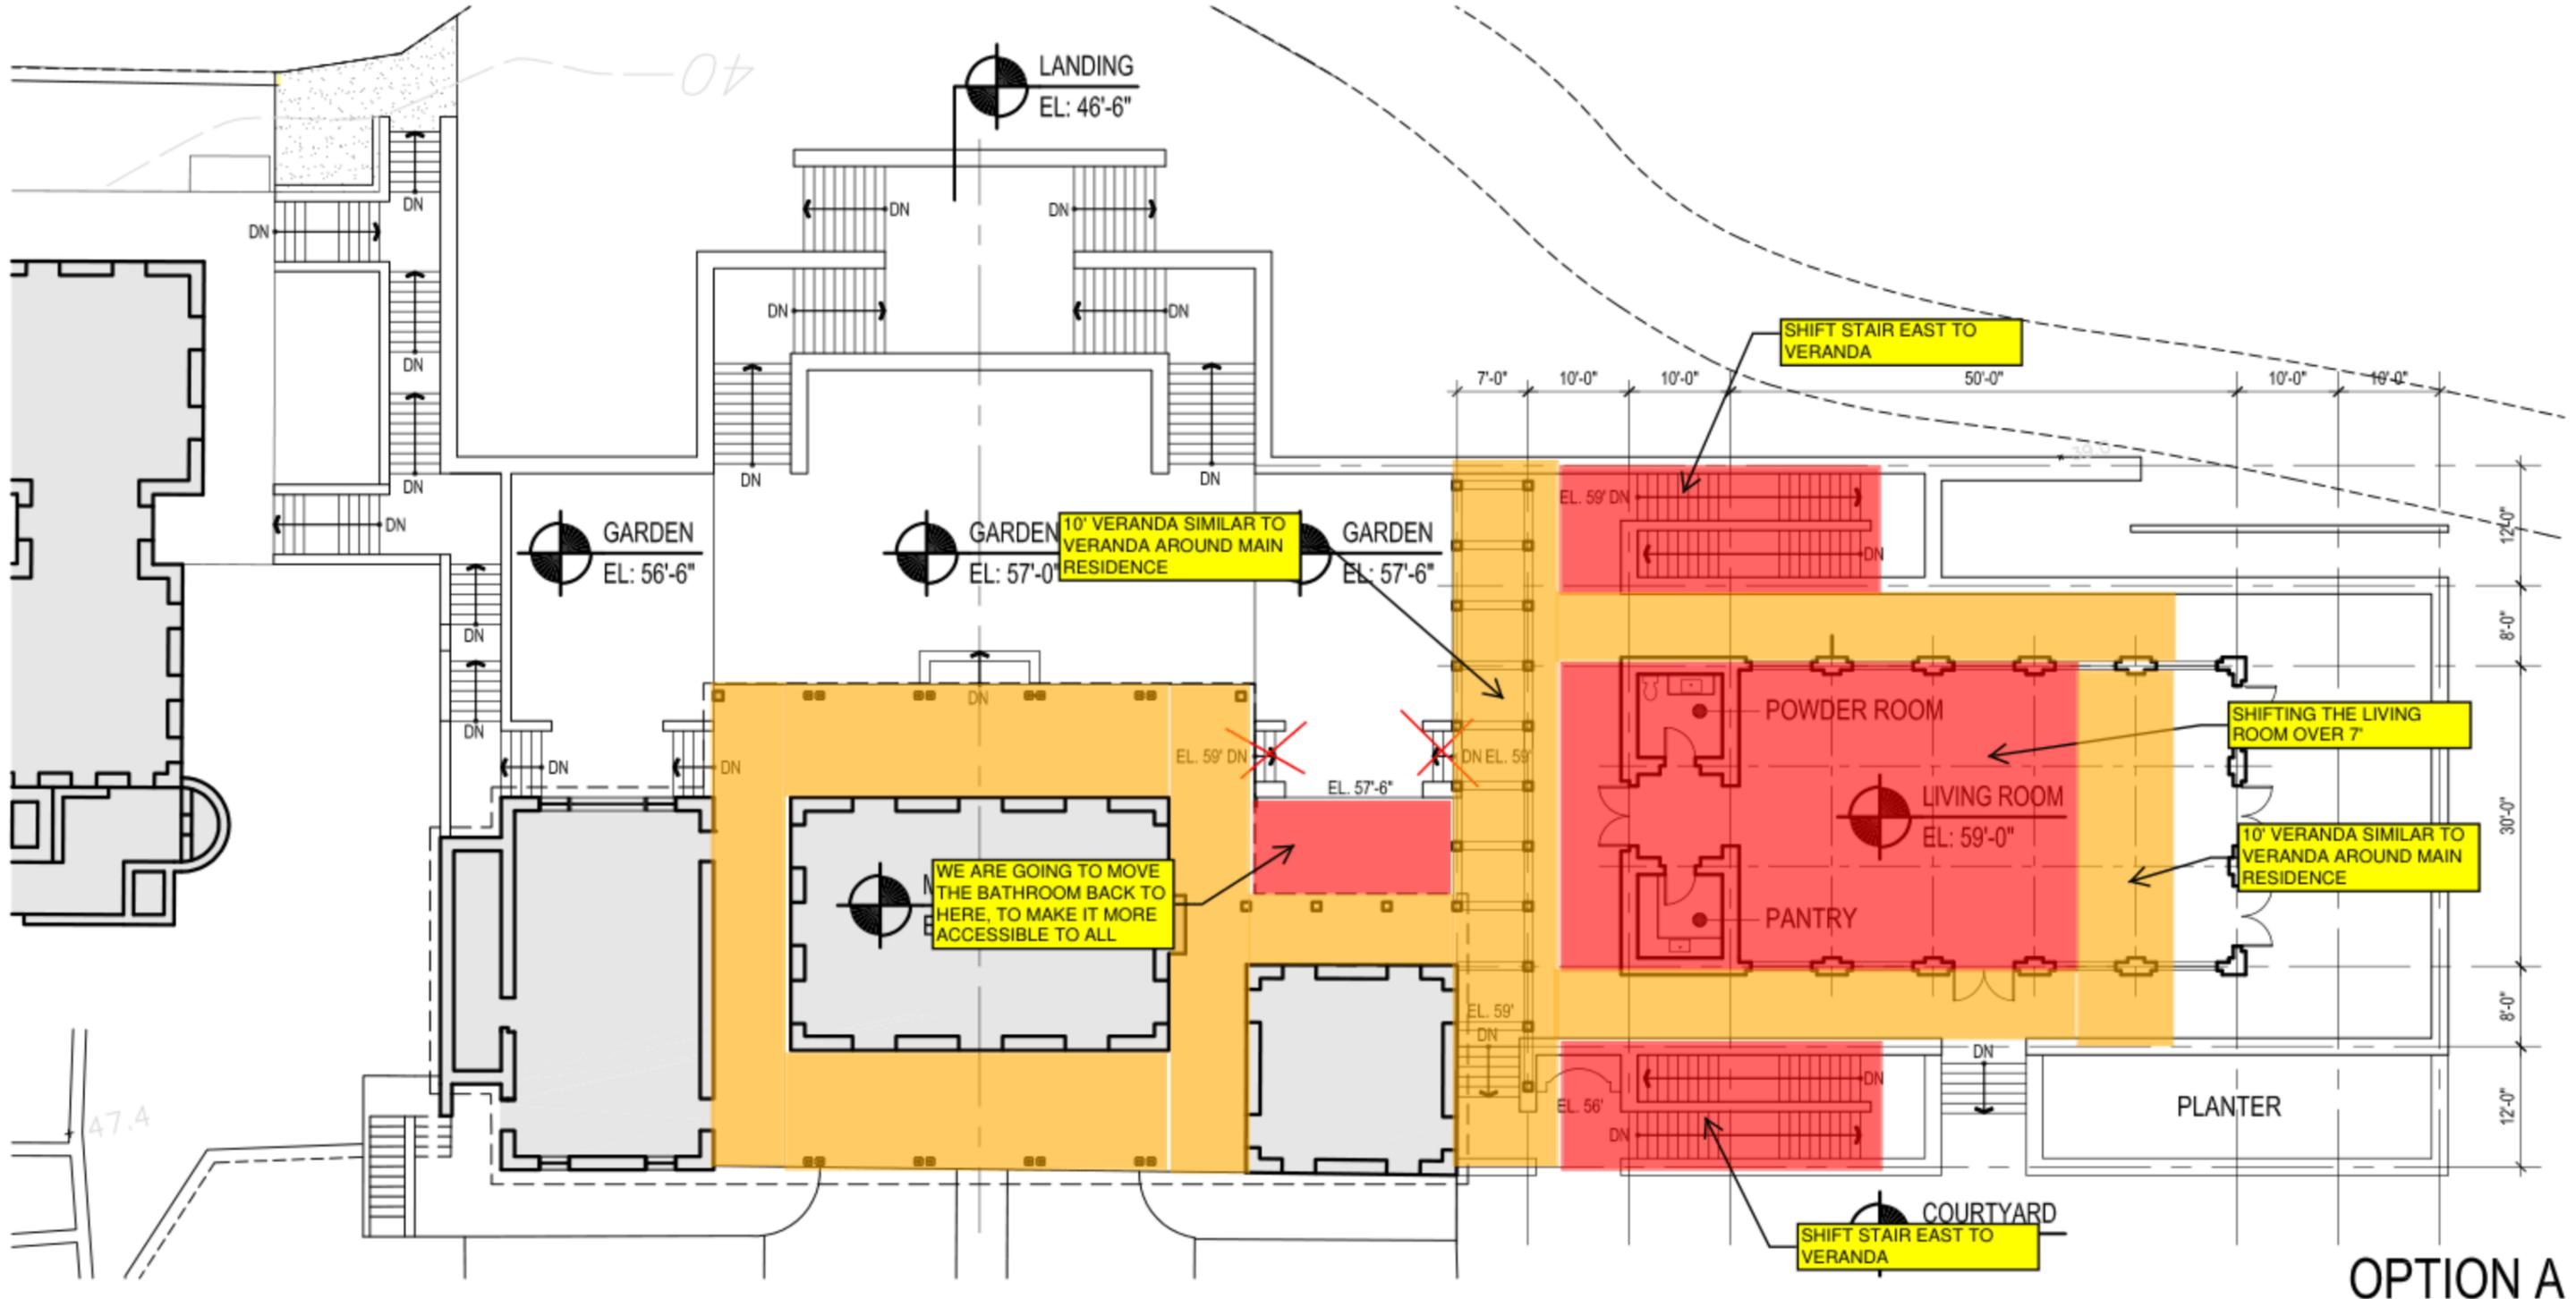

OPTION A

