


LEGEND

	Room reference Drawing number
	Door reference Schedule reference Fire door
	Window reference Schedule reference
	Finished Floor Level

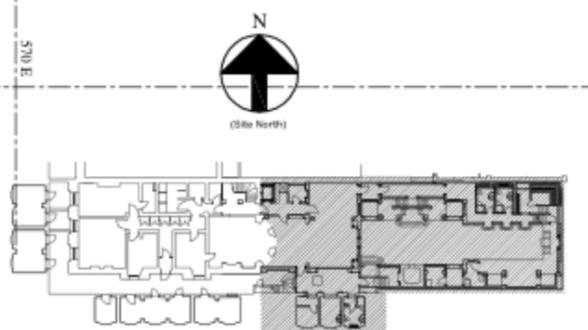

**KEY PLAN
AS BUILT - NOT ISSUED**

No. NOTES (STATUS: F. FEASIBILITY S. SKETCH DESIGN P. PLANNING B. BUILDING CONTROL D. DESIGN DEV. / PRELIM M. MEASUREMENT T. TENDER C. CONSTRUCTION R. RECORD)

No.	Date	By	Check	Revisions
1	10.01.18	AS		LEFT LOBBY REVISED
2	11.04.18	AS		STUDY ROOF PLAN REVISED
3	18.04.18	AS		RE-DRAWN AND REVISED IN AUTOCAD
4	18.04.18	AS		INITIAL ISSUE
5	18.04.18	AS		REVISIONS

DONALD INSALL ASSOCIATES LIMITED
 19 West Essex Place, Essex Square, London, SW1X 8LT, UK
 Tel: [REDACTED] Fax: [REDACTED] Email: [REDACTED]

PROJECT GRENADEIER
 2nd FLOOR PLAN
 AS PROPOSED (MEWS)

Sheet	02/05	of	03
Scale	1:100	of	1:100