



MARKZEFF

TRANSMITTAL

TO: Doug Schoettle
243 Riverside Drive
Atp# 1005
New York, NY 10025

TEL: [REDACTED]

VIA: Email

FROM: Jorge Porta

CC: Gary Kerney, Jeffery Epstein, [REDACTED], Stacie Meador, Mark Zeff

DATE: November 10, 2010

RE. LSJ-Kitchen : Millwork Shop Drawings

There is (are) 10 page(s) of information including this cover page. If you experience any problems in the transmission,

Contact [REDACTED] at (ext 204)

<u>Dated</u>	<u>Qty</u>	<u>Description</u>
11.10.2010	9	Red-lined shop drawings from Tom Hoch

Transmitted:


- As Requested Approved Rejected Examined
 For Review & Comment Approved as Noted Revise & Resubmit Submit Specified Item

Remarks:

Doug,

Enclosed please find shop drawings received from Gary Kerny. All the shops are 'APPROVED AS NOTED' with minor comments. Please review providing additional comments and forward to Gary and any other parties accordingly. Let us know if there is anything else I can do to help.

Sender's Signature: _____
Prepared By: Jorge Porta

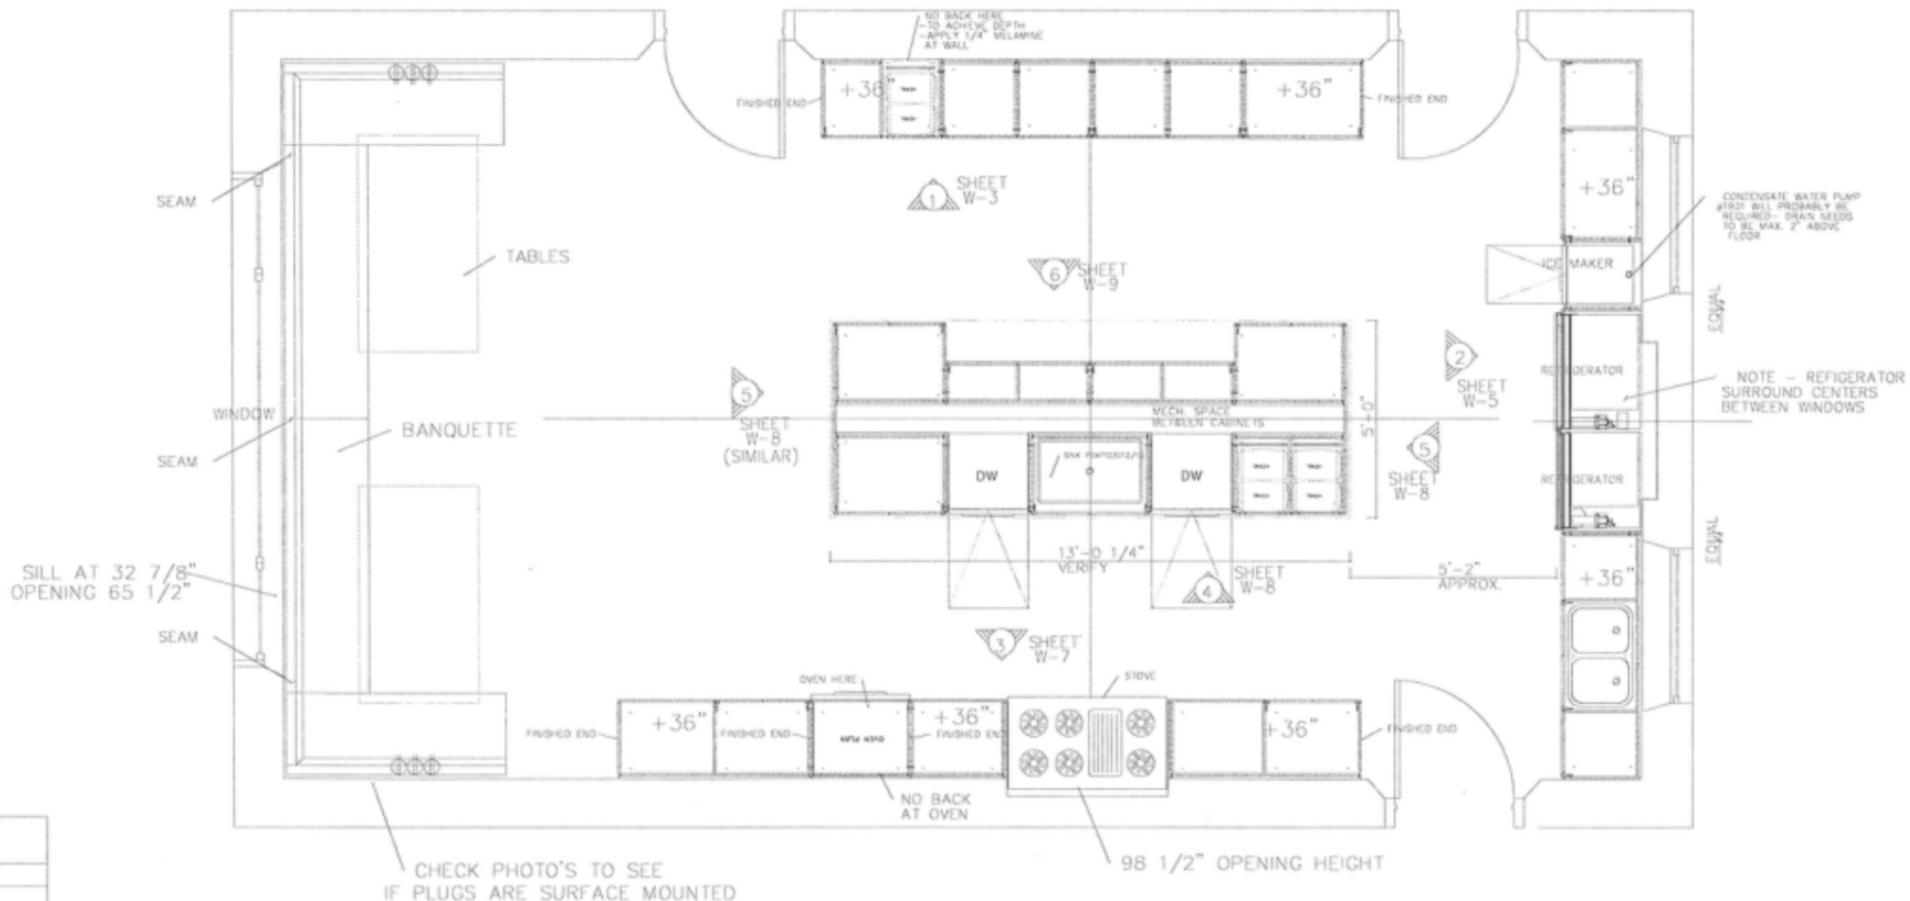

OWNER TO APPROVE ALL APPLIANCES & EQUIPMENT.

HARDWARE/ APPLIANCE SCHEDULE			
DESCRIPTION	MANUFACTURER	MODEL/DESCRIPTION	COLOR/FINISH
COUNTERTOP	CAESARSTONE	#3141 1 1/4" THICK/ 3/4" EDGE	EGGSHELL
DISHWASHERS	KITCHENAID	#KUDC20FYSS	STAINLESS STEEL
STOVE	RE-USE EXISTING	FIELD MEASURED	
EXHAUST HOOD	RE-USE EXISTING	FIELD MEASURED	
30" REFRIG.	SUB-ZERO	#B-30U/S/TH	STAINLESS STEEL
36" REFRIG.	SUB-ZERO	#B-36U/S/TH	STAINLESS STEEL
OVEN/MICROWAVE	MAYTAG	#MMW7530WDS	STAINLESS STEEL
COFFEE MAKER	NOT AVAILABLE		
ICE MAKER	KITCHENAID	#KUD1BNV (18")	STAINLESS STEEL
DISPOSERATOR	NOT AVAILABLE		
DOUBLE BASIN SINK	FRANKE	#ARK12031	STAINLESS STEEL
SINGLE BASIN SINK	FRANKE	#PSK1103012/14	STAINLESS STEEL
PUCK LIGHTS	LUCIFER LIGHTING	UNLENSED LPK-12-10-W ORDER AS KITS ORDER W/ TRANSFORMERS ORDER SURFACE COLLARS, WIRES, & CLIPS.	WHITE
CABINET PULLS	HAFELE	#117.05.600 SMALL PULL (146MM)	STAINLESS STEEL
CABINET PULLS	HAFELE	#117.05.680 LARGE PULL (222MM)	STAINLESS STEEL
CABINET HINGE	PRIDE INDUSTRIAL	#3803 FULL OVERLAY W/ "SOFT CLOSE"	NICKEL
CABINET HINGE	PRIDE INDUSTRIAL	#3804 HALF OVERLAY W/ "SOFT CLOSE"	NICKEL
DRAWER SLIDES 20"	KNAUF & YOGI	#8455-20 FULL EXT. W/ "SELF-CLOSING"	FROSTED NICKEL
LEVELER/LEGS	HAFELE	#637 15-219 WITH TDE-KICK CLIPS (#637.19.004)	ZINC/ BLACK PLASTIC
WASTE BIN GLIDES	HAFELE	#JSC15-2-3MPT (3IN DJART) COMES WITH WASTE BINS (PLATINUM)	PLATINUM FINISH
WIRE DROWNETS (HIDDEN IN VIEW BACK OF CABINETS)	DOUG HOCKET	2" X 4" WILL BE USED ONLY IF CUT-OUTS MADE IN BACK OF CABINETS (NOT TYPICAL)	PLASTIC

PLAN
SCALE: 1/2" = 1' 0"

PROVIDE DESIGNER W/ FINISH SAMPLES FOR APPROVAL PRIOR TO FABRICATION

MATERIALS : MEDIUM DENSITY FIBREBOARD PRIME HEAVILY AS SHEET GOODS AND LACQUER W/ GLOSS FINISH

INTERIORS : 3/4" WHITE MELAMINE WITH WHITE EDGE BAND AT NON-EXPOSED EDGES. CANPLAST DESIGNER WHITE #1474 TM

FINISH : CUSTOM MATCHED LACQUER "GLOSS" INDUSTRIAL FURNITURE FINISH MATCHES BENJAMIN MOORE CHANTILLY LACE 2121-70 COLOR. SW CAB-ACRYLIC WHITE BASE W/ CLEARCOAT. WET SAND GRITS TO 1500 AND BUFF/POLISH.

HARDWARE : MATTE STAINLESS STEEL/ FROSTED NICKEL

COUNTERS : (BY OTHERS) 1 1/4" CAESARSTONE #3141 COLOR: EGGSHELL


- APPROVED
- REJECTED
- EXAMINED
- APPROVED AS NOTED
- REVISE AND RESUBMIT
- SUBMIT SPECIFIED ITEM

CHECKING IS ONLY FOR GENERAL CONFORMANCE WITH THE DESIGN CONCEPT OF THE PROJECT AND GENERAL COMPLIANCE WITH THE INFORMATION GIVEN IN THE CONTRACT DOCUMENTS. CONTRACTOR IS RESPONSIBLE FOR DIMENSIONS WHICH SHALL BE CONFIRMED AND CORRECTED AT THE JOB SITE: FABRICATION PROCESSES AND TECHNIQUES OF CONSTRUCTION, AND COORDINATION OF THIS WORK WITH THE WORK OF ALL OTHER TRADES. ALL WOOD TO BE FIRE TREATED/RETARDANT TO MEET FIRE RATING AS PER LOCAL, STATE AND FEDERAL CODE.


- MARKZEFF -

11.10.2010
DATE REF# SIGNATURE

SCALE: AS NOTED DRAWN BY: KAS	PROJECT: LITTLE ST. JAMES SHEET TITLE: KITCHEN PLAN/ SECTIONS SHEET 1 OF 9	REVISED:	DATE: 10/25/10 SHEET #: W-1
-------------------------------	----------------------------------------------------------------------------	----------	-----------------------------

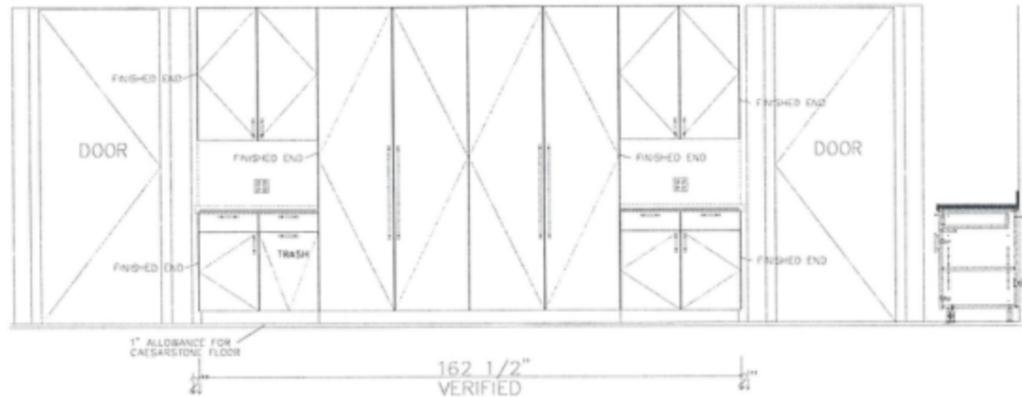


① ELEVATION
SCALE: 1/2" = 1' 0"

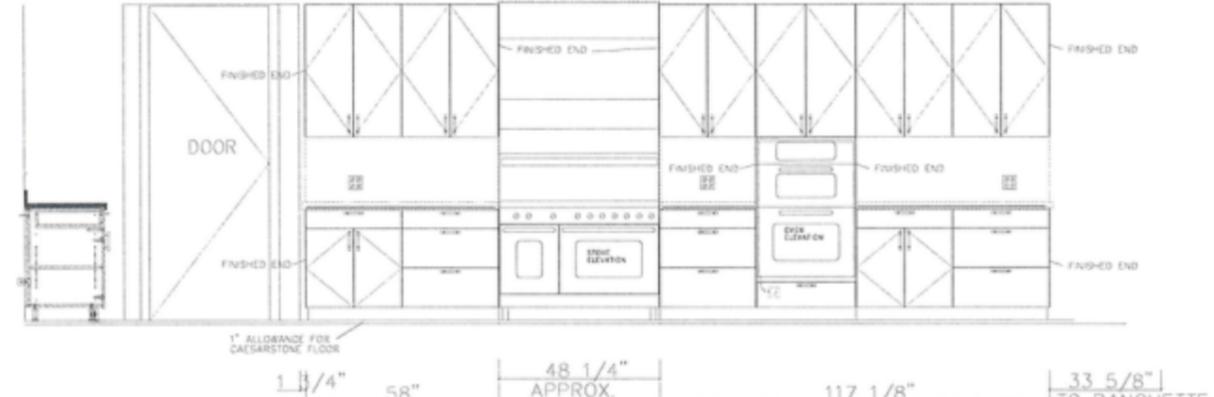


② ELEVATION
SCALE: 1/2" = 1' 0"


2 3/16" 68 1/2" 2 1/8"
CENTER ON WINDOWS

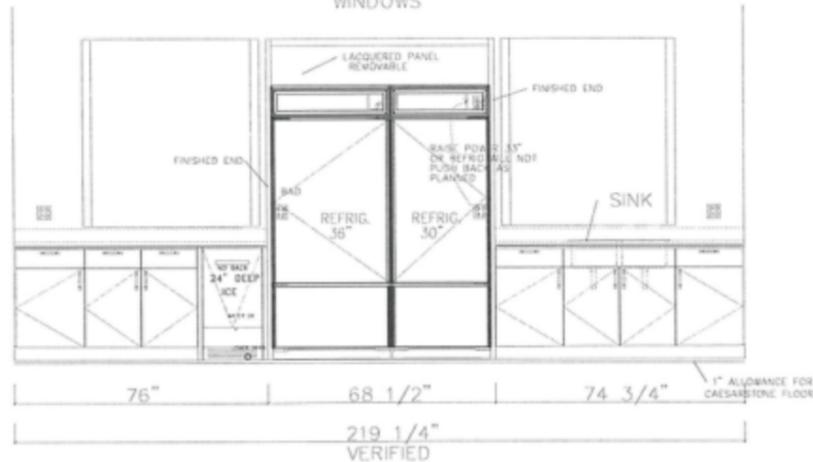


③ ELEVATION
SCALE: 1/2" = 1' 0"

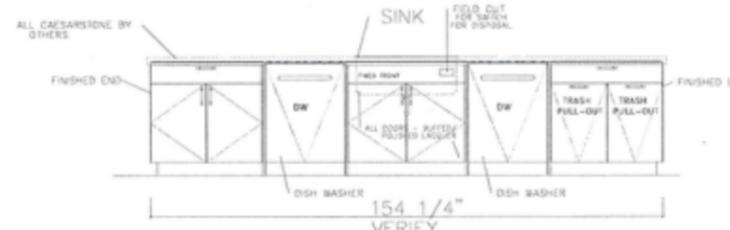

④ ELEVATION
SCALE: 1/2" = 1' 0"

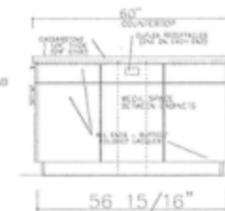

⑤ ELEVATION
SCALE: 1/2" = 1' 0"

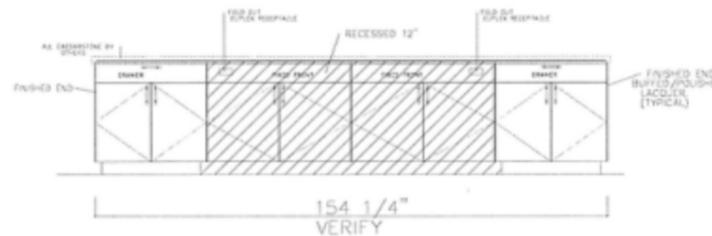

⑥ ELEVATION
SCALE: 1/2" = 1' 0"

- APPROVED
- REJECTED
- EXAMINED
- APPROVED AS NOTED
- REVISE AND RESUBMIT
- SUBMIT SPECIFIED ITEM

CHECKING IS ONLY FOR GENERAL CONFORMANCE WITH THE DESIGN CONCEPT OF THE PROJECT AND GENERAL COMPLIANCE WITH THE INFORMATION GIVEN IN THE CONTRACT DOCUMENTS. CONTRACTOR IS RESPONSIBLE FOR DIMENSIONS WHICH SHALL BE CONFIRMED AND CORRELATED AT THE JOB SITE. FABRICATION PROCESSES AND TECHNIQUES OF CONSTRUCTION, AND COORDINATION OF THIS WORK WITH THE WORK OF ALL OTHER TRADES. ALL WOOD TO BE TREATED/RETARANT TO MEET FIRE RATING AS PER LOCAL, STATE AND FEDERAL CODE.

- MARKZEFF -





11.10.2010
DATE REF# SIGNATURE

PROVIDE DESIGNER W/
FINISH SAMPLES FOR
APPROVAL

- MATERIALS : MEDIUM DENSITY FIBREBOARD
PRIME HEAVILY AS SHEET GOODS
AND LACQUER W/ GLOSS FINISH
- INTERIORS : 3/4" WHITE MELAMINE WITH
WHITE EDGE BAND AT NON-EXPOSED
EDGES. CANPLAST DESIGNER WHITE
#1474 TM
- FINISH : CUSTOM MATCHED LACQUER
"GLOSS" INDUSTRIAL FURNITURE FINISH
MATCHES BENJAMIN MOORE
CHANTILLY LACE 2121-70 COLOR.
SW CAB-ACRYLIC WHITE BASE W/
CLEARCOAT. WET SAND GRITS TO
1500 AND BUFF/POLISH.
- HARDWARE : MATTE STAINLESS STEEL/
FROSTED NICKEL
- COUNTERS : (BY OTHERS) 1 1/4" CAESARSTONE
#3141 COLOR: EGGSHELL

SCALE: AS NOTED DRAWN BY KAS	PROJECT: LITTLE ST. JAMES SHEET TITLE: KITCHEN ELEVATIONS SHEET 2 OF 9	REVISED: 	DATE: 10/25/10 SHEET #: W-2
---------------------------------------	---------------------------------------------------------------------------------	----------------------	--------------------------------------

2 PUCK LIGHTS PER CAB.
(4 TOTAL THIS ELEV. 1)
AND TRANSFORMER

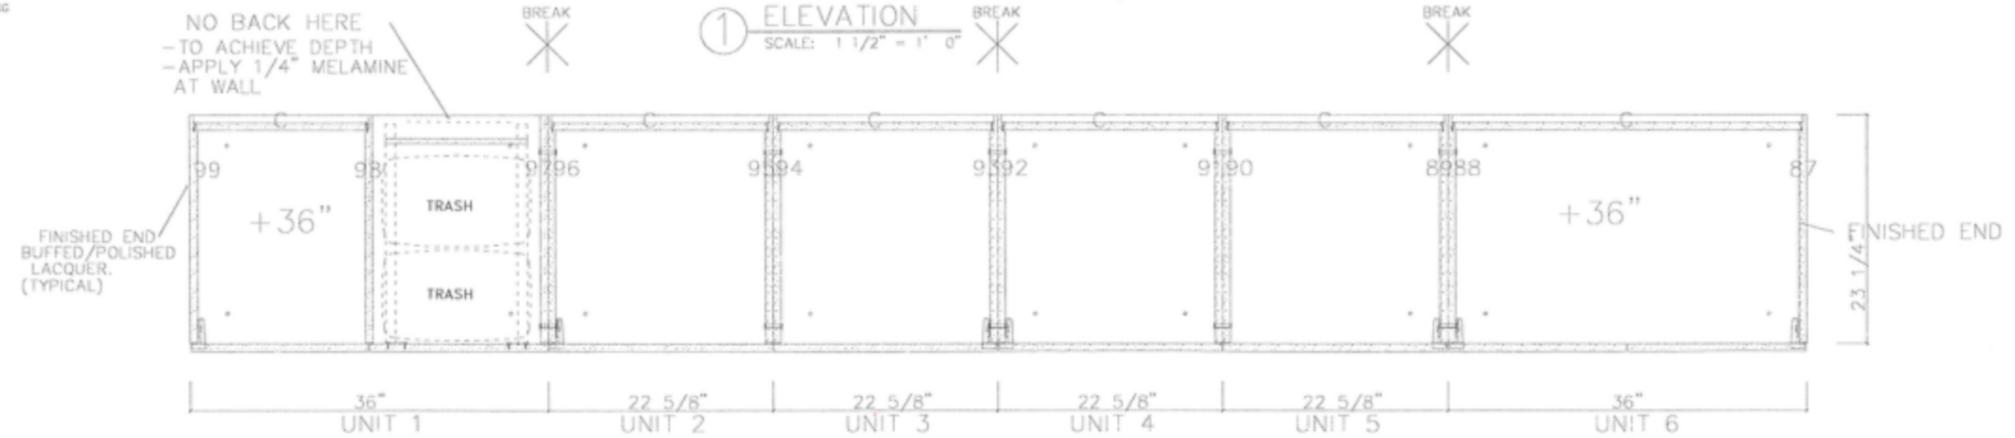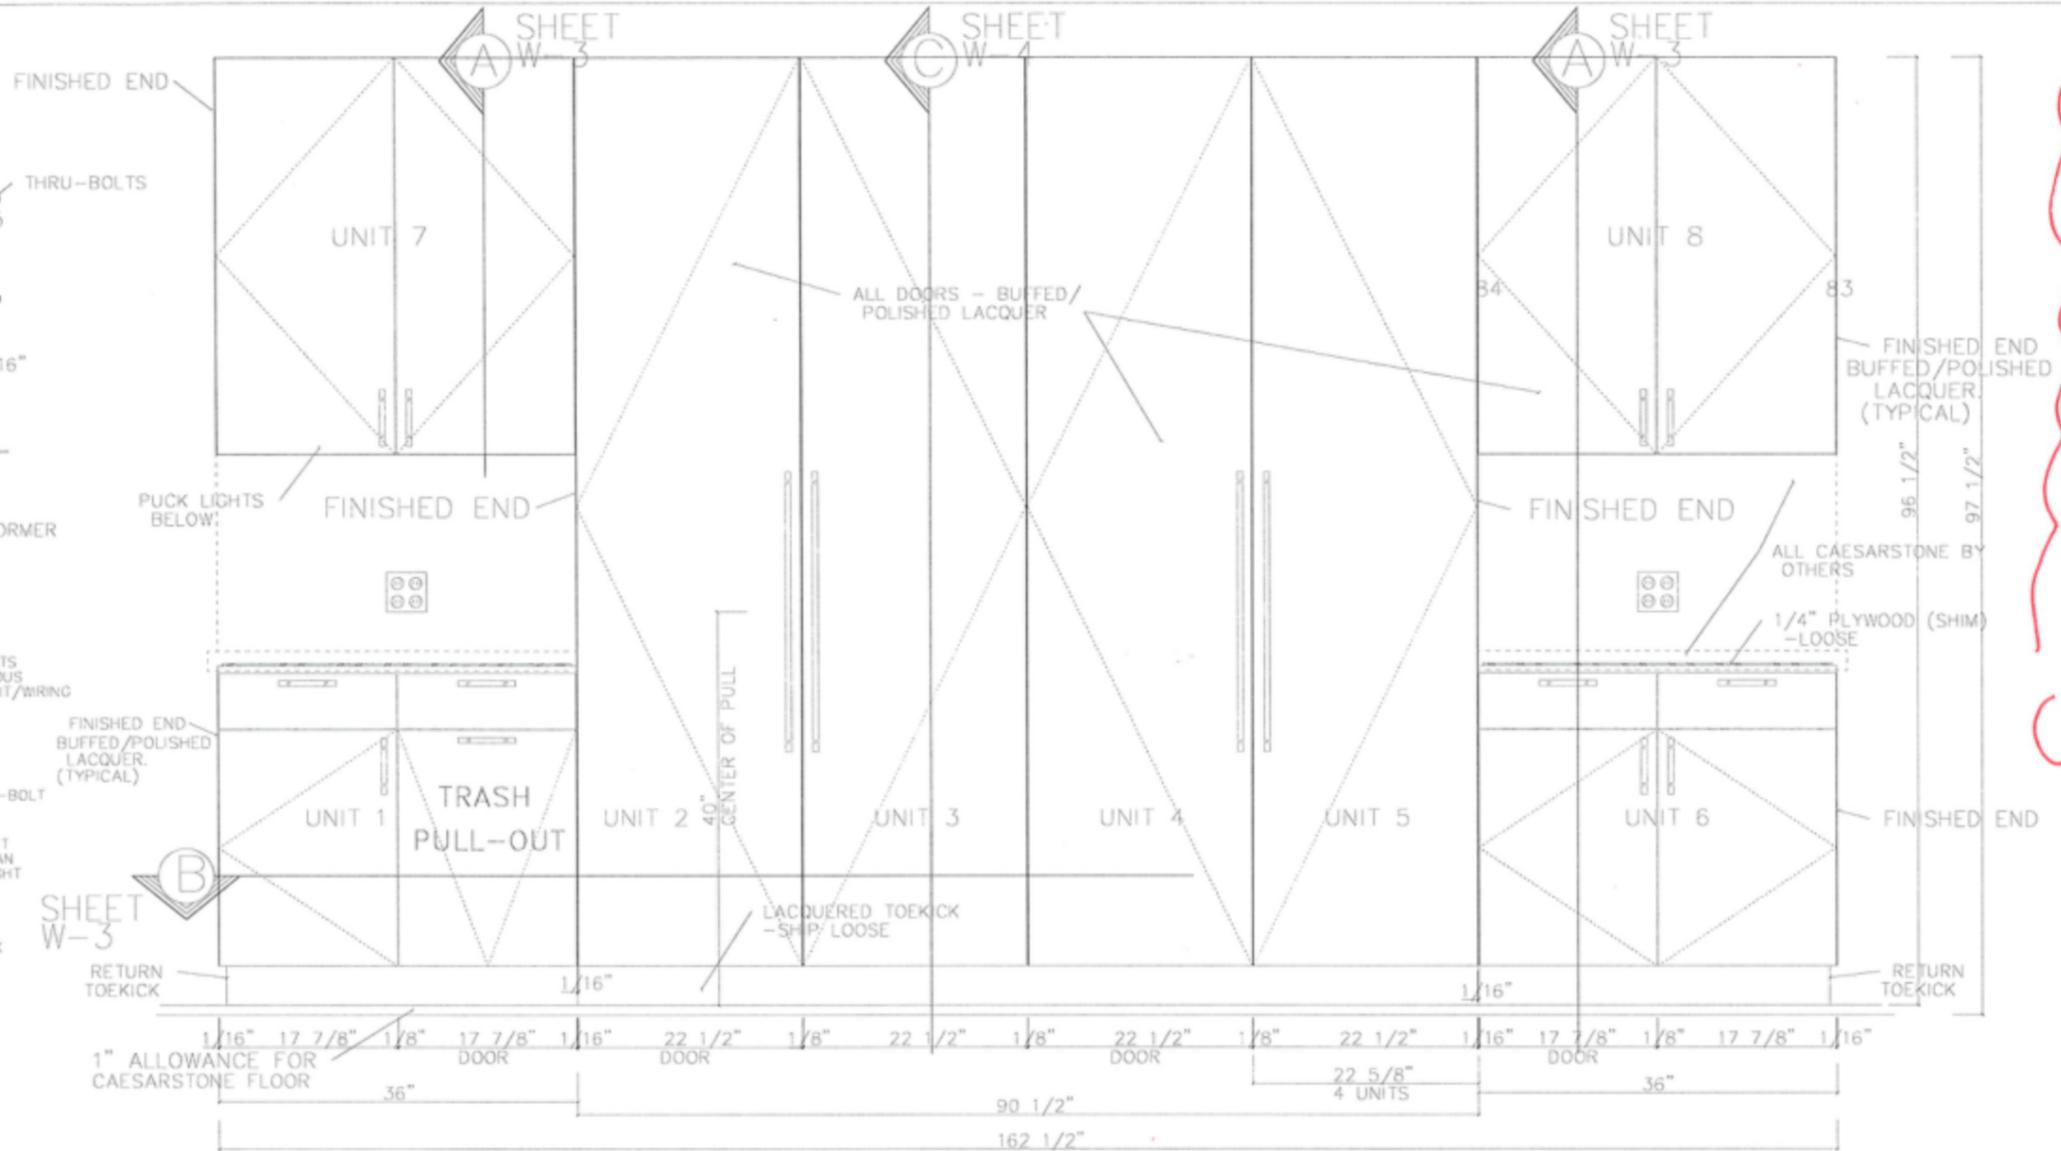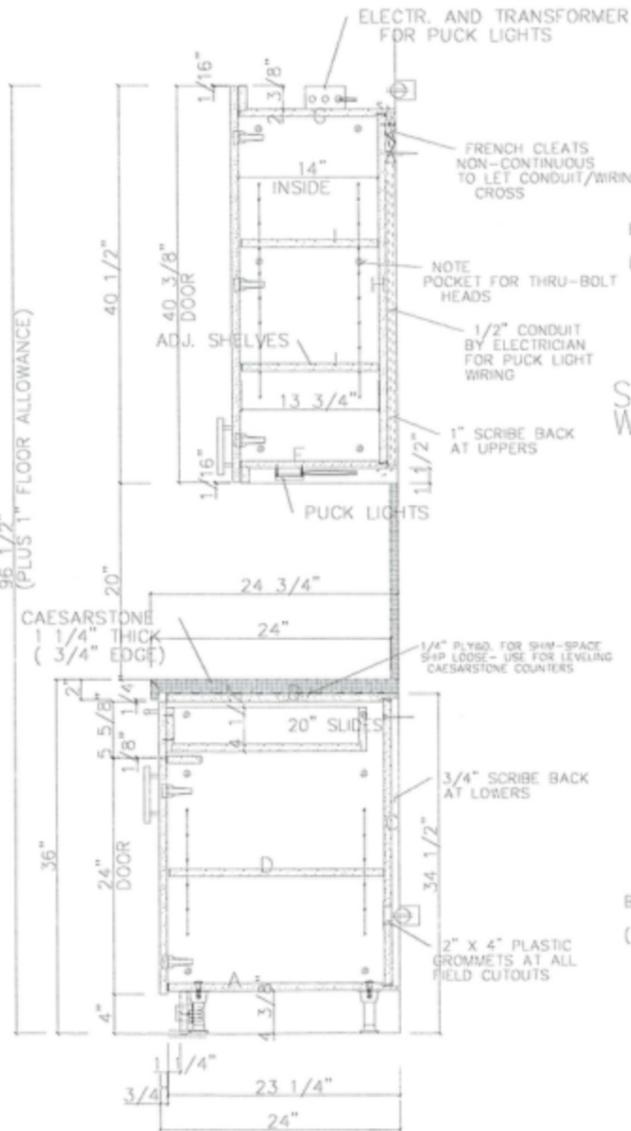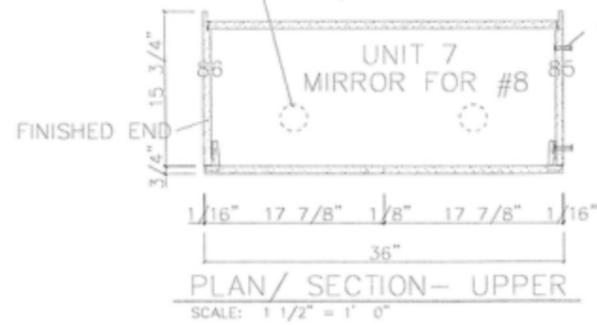

ALL CABINET INTERIORS - WHITE MELAMINE
ALL CABN'T EXTERIORS - POLISHED LACQUER

SCALE: AS NOTED DRAWN BY KAS




PROJECT: LITTLE ST. JAMES
SHEET TITLE: KITCHEN ELEV./SECTION
SHEET 3 OF 9


REVISED:	DATE:
	10/25/10
	SHEET #:
	W-3

PROVIDE DESIGNER W/ FINISA SAMPLES PRIOR TO FABRICATION

APPROVED 11.10.2010 MARK ZEPF.

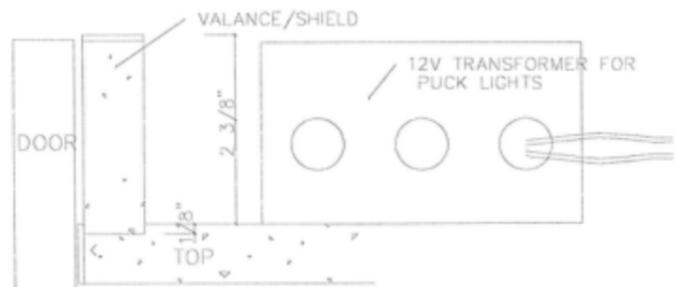



UPPER CABINET TOP
FULL

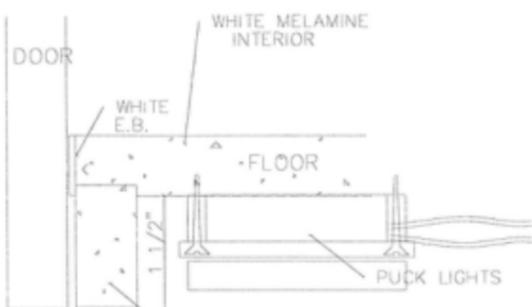


UPPER CABINET FLOOR
FULL




UPPER CABINET BACK
FULL

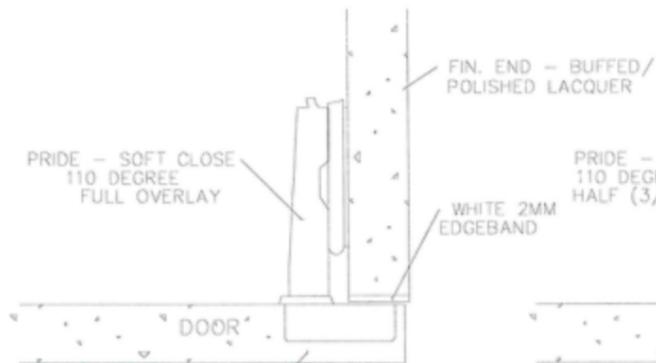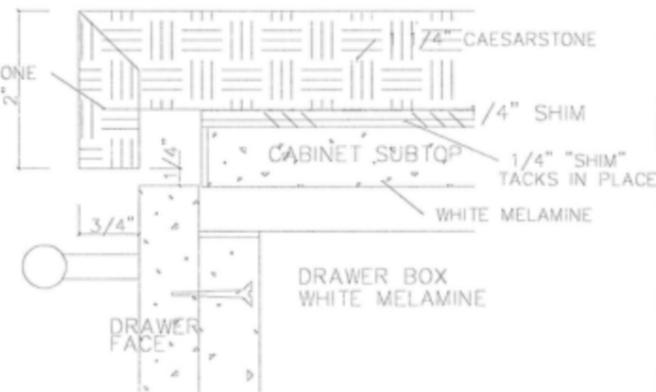


FULL OVERLAY DOOR
FULL

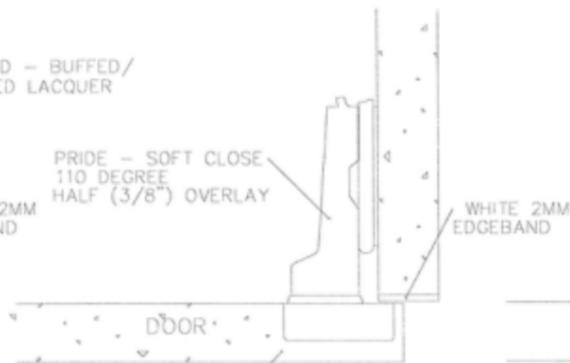


HALF OVERLAY DOOR
FULL

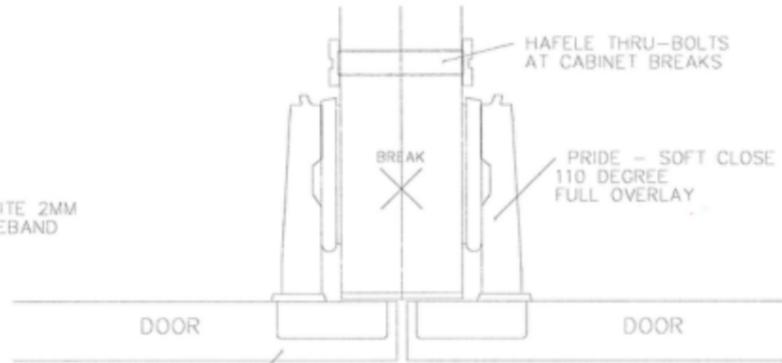


CABINET BREAK
FULL

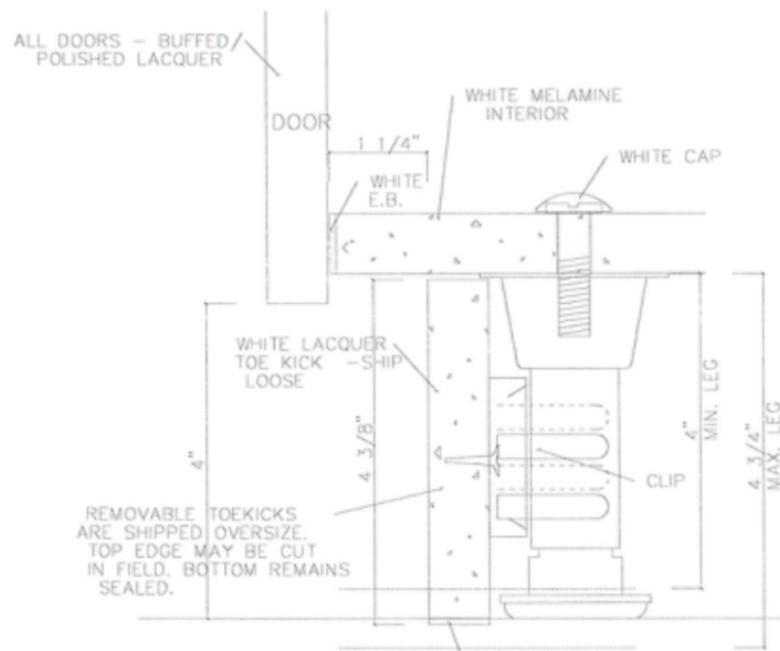


TYP. BASE CAB TOEKICK
FULL

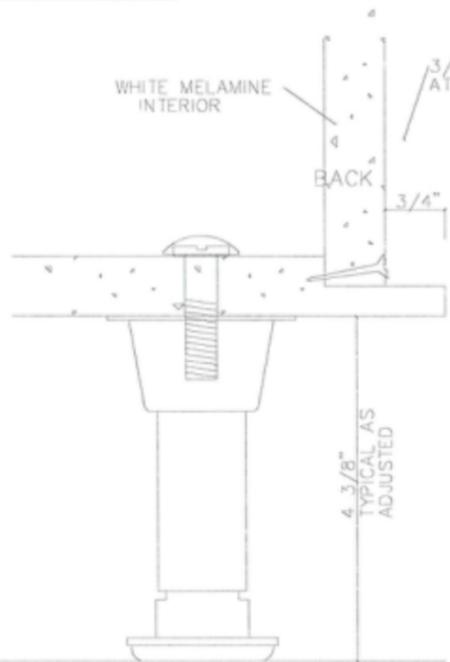

TYP. BASE CAB BACK
FULL

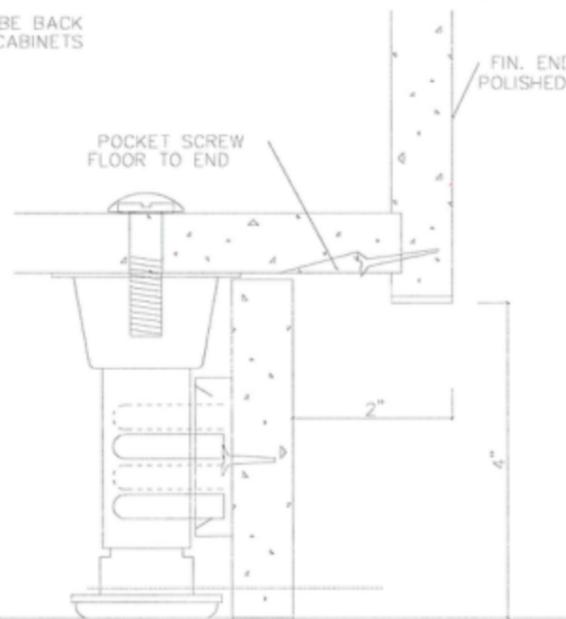

TYP. BASE CAB END
FULL

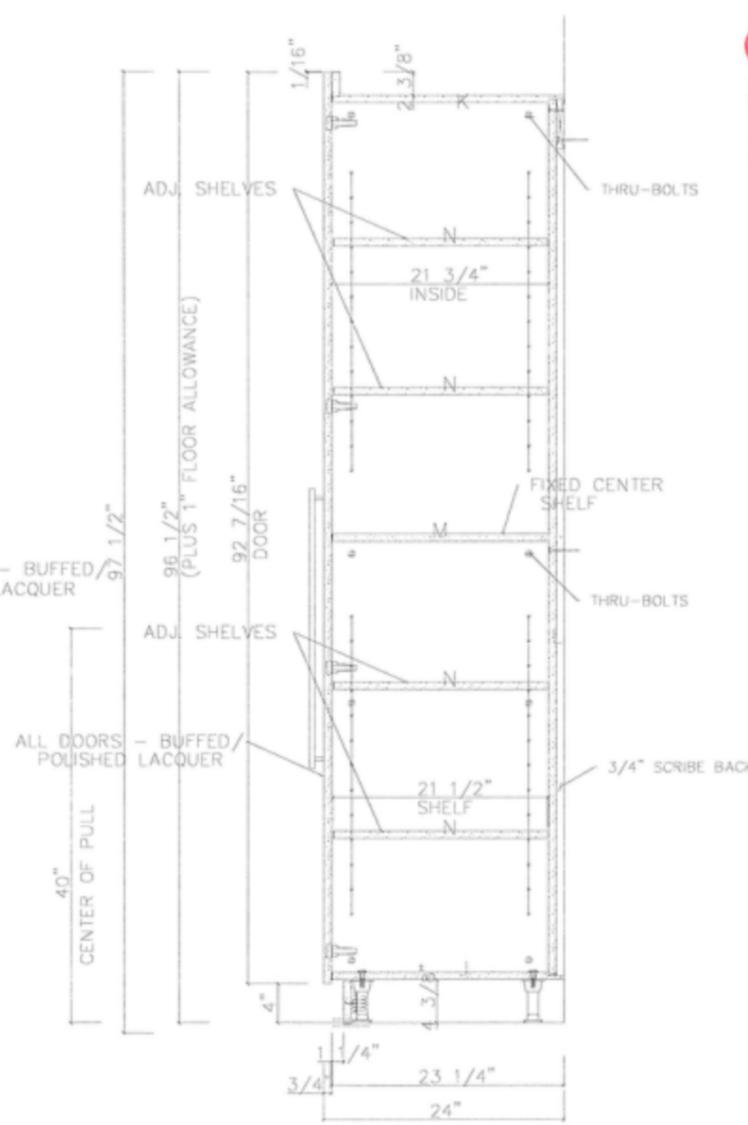

SECTION
SCALE: 1 1/2" = 1' 0"

ALL CABINET INTERIORS - WHITE MELAMINE
ALL CABN'T EXTERIORS - POLISHED LACQUER

SCALE:
AS NOTED
DRAWN BY
KAS



PROJECT: LITTLE ST. JAMES
SHEET TITLE:
KITCHEN SECTION/ DETAILS
SHEET 4 OF 9

REVISED:	DATE:
	10/25/10
	SHEET #:
	W-4

PROVIDE FINISH SAMPLES
FOR APPROVAL TO DESIGNER
PRIOR TO FABRICATION

APPROVED 11.10.2010
MANK ZEFF