


SHEET W-5
D

22 1/16" 20 1/2" 1/8" 16 7/8" 1/8" 16 7/8" 1/16" 18" 1 1/2" 1 1/2" 65 1/2" 68 1/2" 1 1/2" 20 3/16" 1/8" 16 3/4" 1/8" 16 3/4" 1/8" 20 3/16" 7 1/16" 1" ALLOWANCE FOR CAESARSTONE FLOOR

② ELEVATION
SCALE: 1 1/2" = 1' 0"

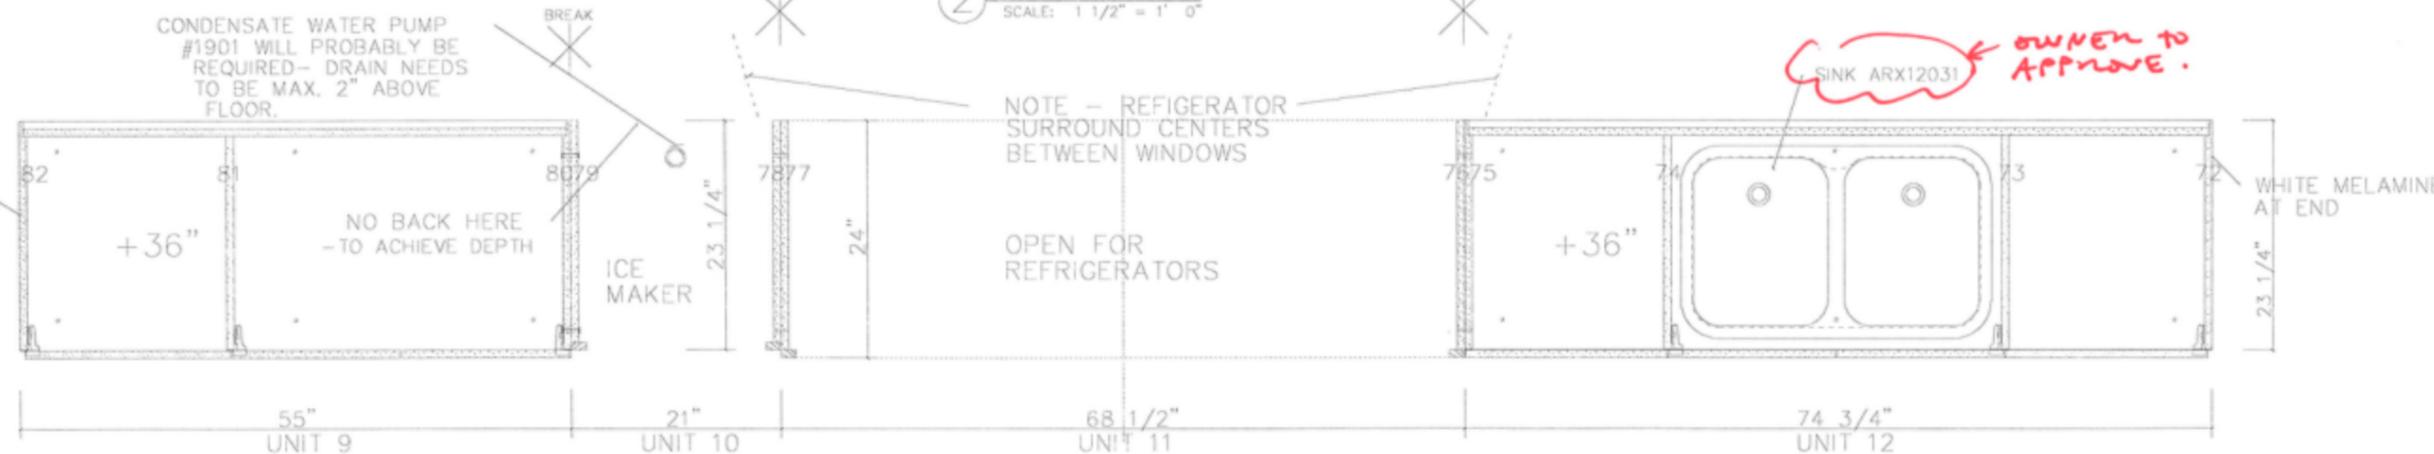




① PLAN/SECTION
SCALE: 1 1/2" = 1' 0"

ALL CABINET INTERIORS - WHITE MELAMINE
ALL CABN'T EXTERIORS - POLISHED LACQUER

SCALE: AS NOTED DRAWN BY KAS	PROJECT: LITTLE ST. JAMES SHEET TITLE: KITCHEN ELEV./SECTION SHEET 5 OF 9	REVISED:	DATE: 10/25/10 SHEET #: W-5
---------------------------------------	------------------------------------------------------------------------------------	----------	--------------------------------------

PROVIDE DESIGNER W/ FINISH SAMPLES FOR APPROVAL PRIOR TO FABRICATION. OWNER TO APPROVE APPLIANCES & PUMMING FIXTURES.

APPROVED AS NOTED 11.10.2010
MARK ZEFF

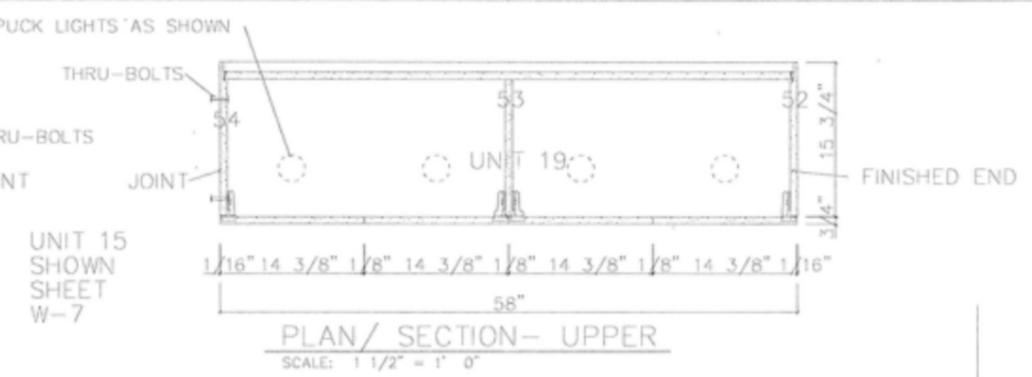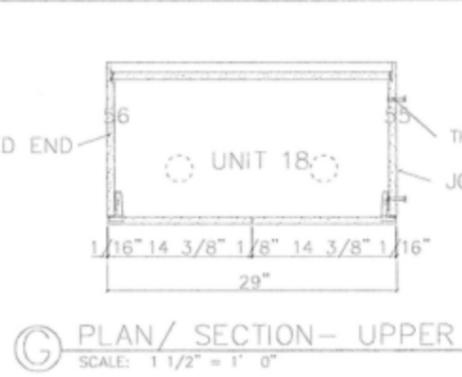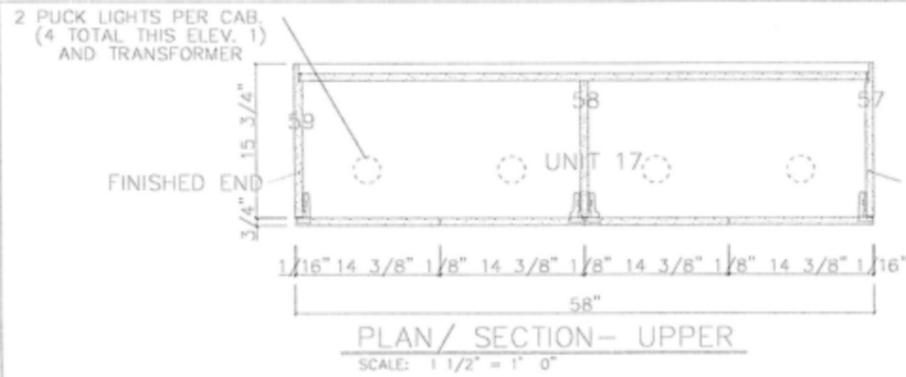

PROVIDE DESIGNER W/ FINISH SAMPLES FOR APPROVAL PRIOR TO FABRICATION


OWNER TO APPROVE ALL APPLIANCES.

- APPROVED
- REJECTED
- EXAMINED
- APPROVED AS NOTED
- REVISE AND RESUBMIT
- SUBMIT SPECIFIED ITEM


CHECKING IS ONLY FOR GENERAL CONFORMANCE WITH THE DESIGN CONCEPT OF THE PROJECT AND GENERAL COMPLIANCE WITH THE INFORMATION GIVEN IN THE CONTRACT DOCUMENTS. CONTRACTOR IS RESPONSIBLE FOR DIMENSIONS WHICH SHALL BE CONFIRMED AND CORRELATED AT THE JOB SITE; FABRICATION PROCESSES AND TECHNIQUES OF CONSTRUCTION, AND COORDINATION OF THIS WORK WITH THE WORK OF ALL OTHER TRADES. ALL WOOD TO BE FIRE TREATED/RETARDANT TO MEET FIRE RATING AS PER LOCAL, STATE AND FEDERAL CODE.

- MARKZEFF -

11.10.2010 DATE REF# SIGNATURE

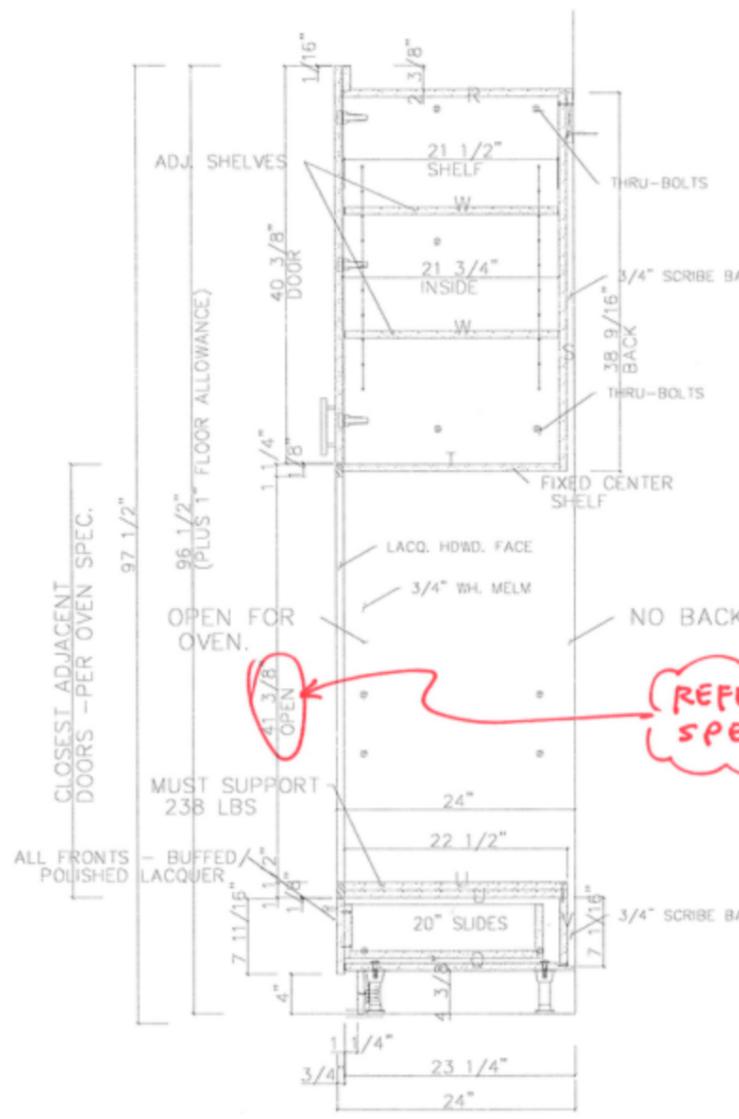

REMOVABLE LACQUERED PANEL (ON EARTH MAGNETS)
-RUN DOWN 1/16" SO PANEL RECESSES 1/16"
-REBATE AT BOTTOM LETS WEB FRAME CARRY WEIGHT AND SUPPORT VERTICALLY.

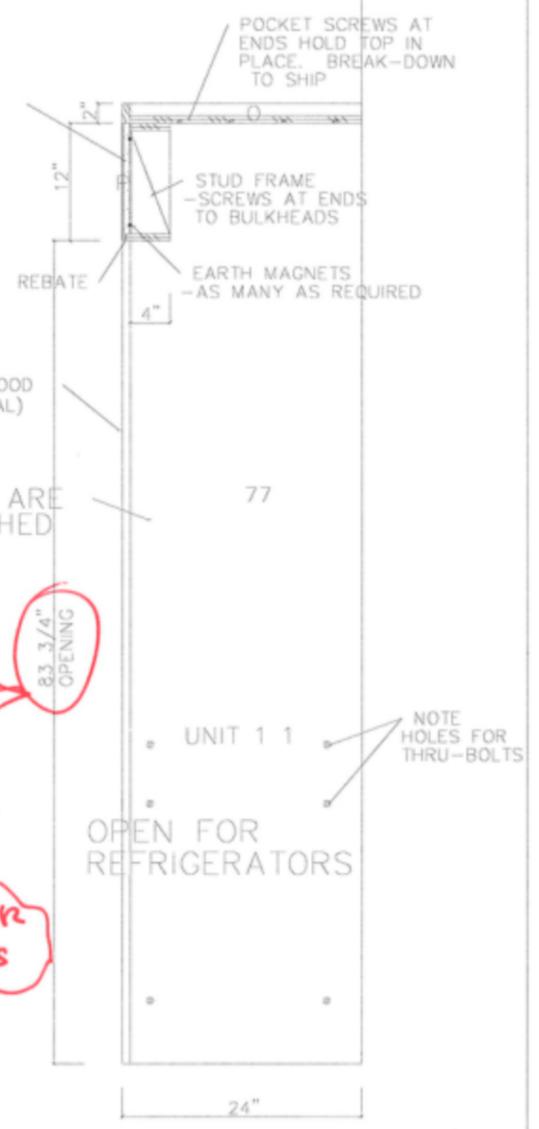


REFER OVEN SPEC.

REFER REFRIGERATOR SPECIFICATIONS

ALL CABINET INTERIORS - WHITE MELAMINE
ALL CABN'T EXTERIORS - POLISHED LACQUER


SCALE: AS NOTED DRAWN BY: KAS	PROJECT: LITTLE ST. JAMES SHEET TITLE: KITCHEN SECTIONS SHEET 6 OF 9	REVISED:	DATE: 10/25/10 SHEET #: W-6
-------------------------------	----------------------------------------------------------------------	----------	-----------------------------

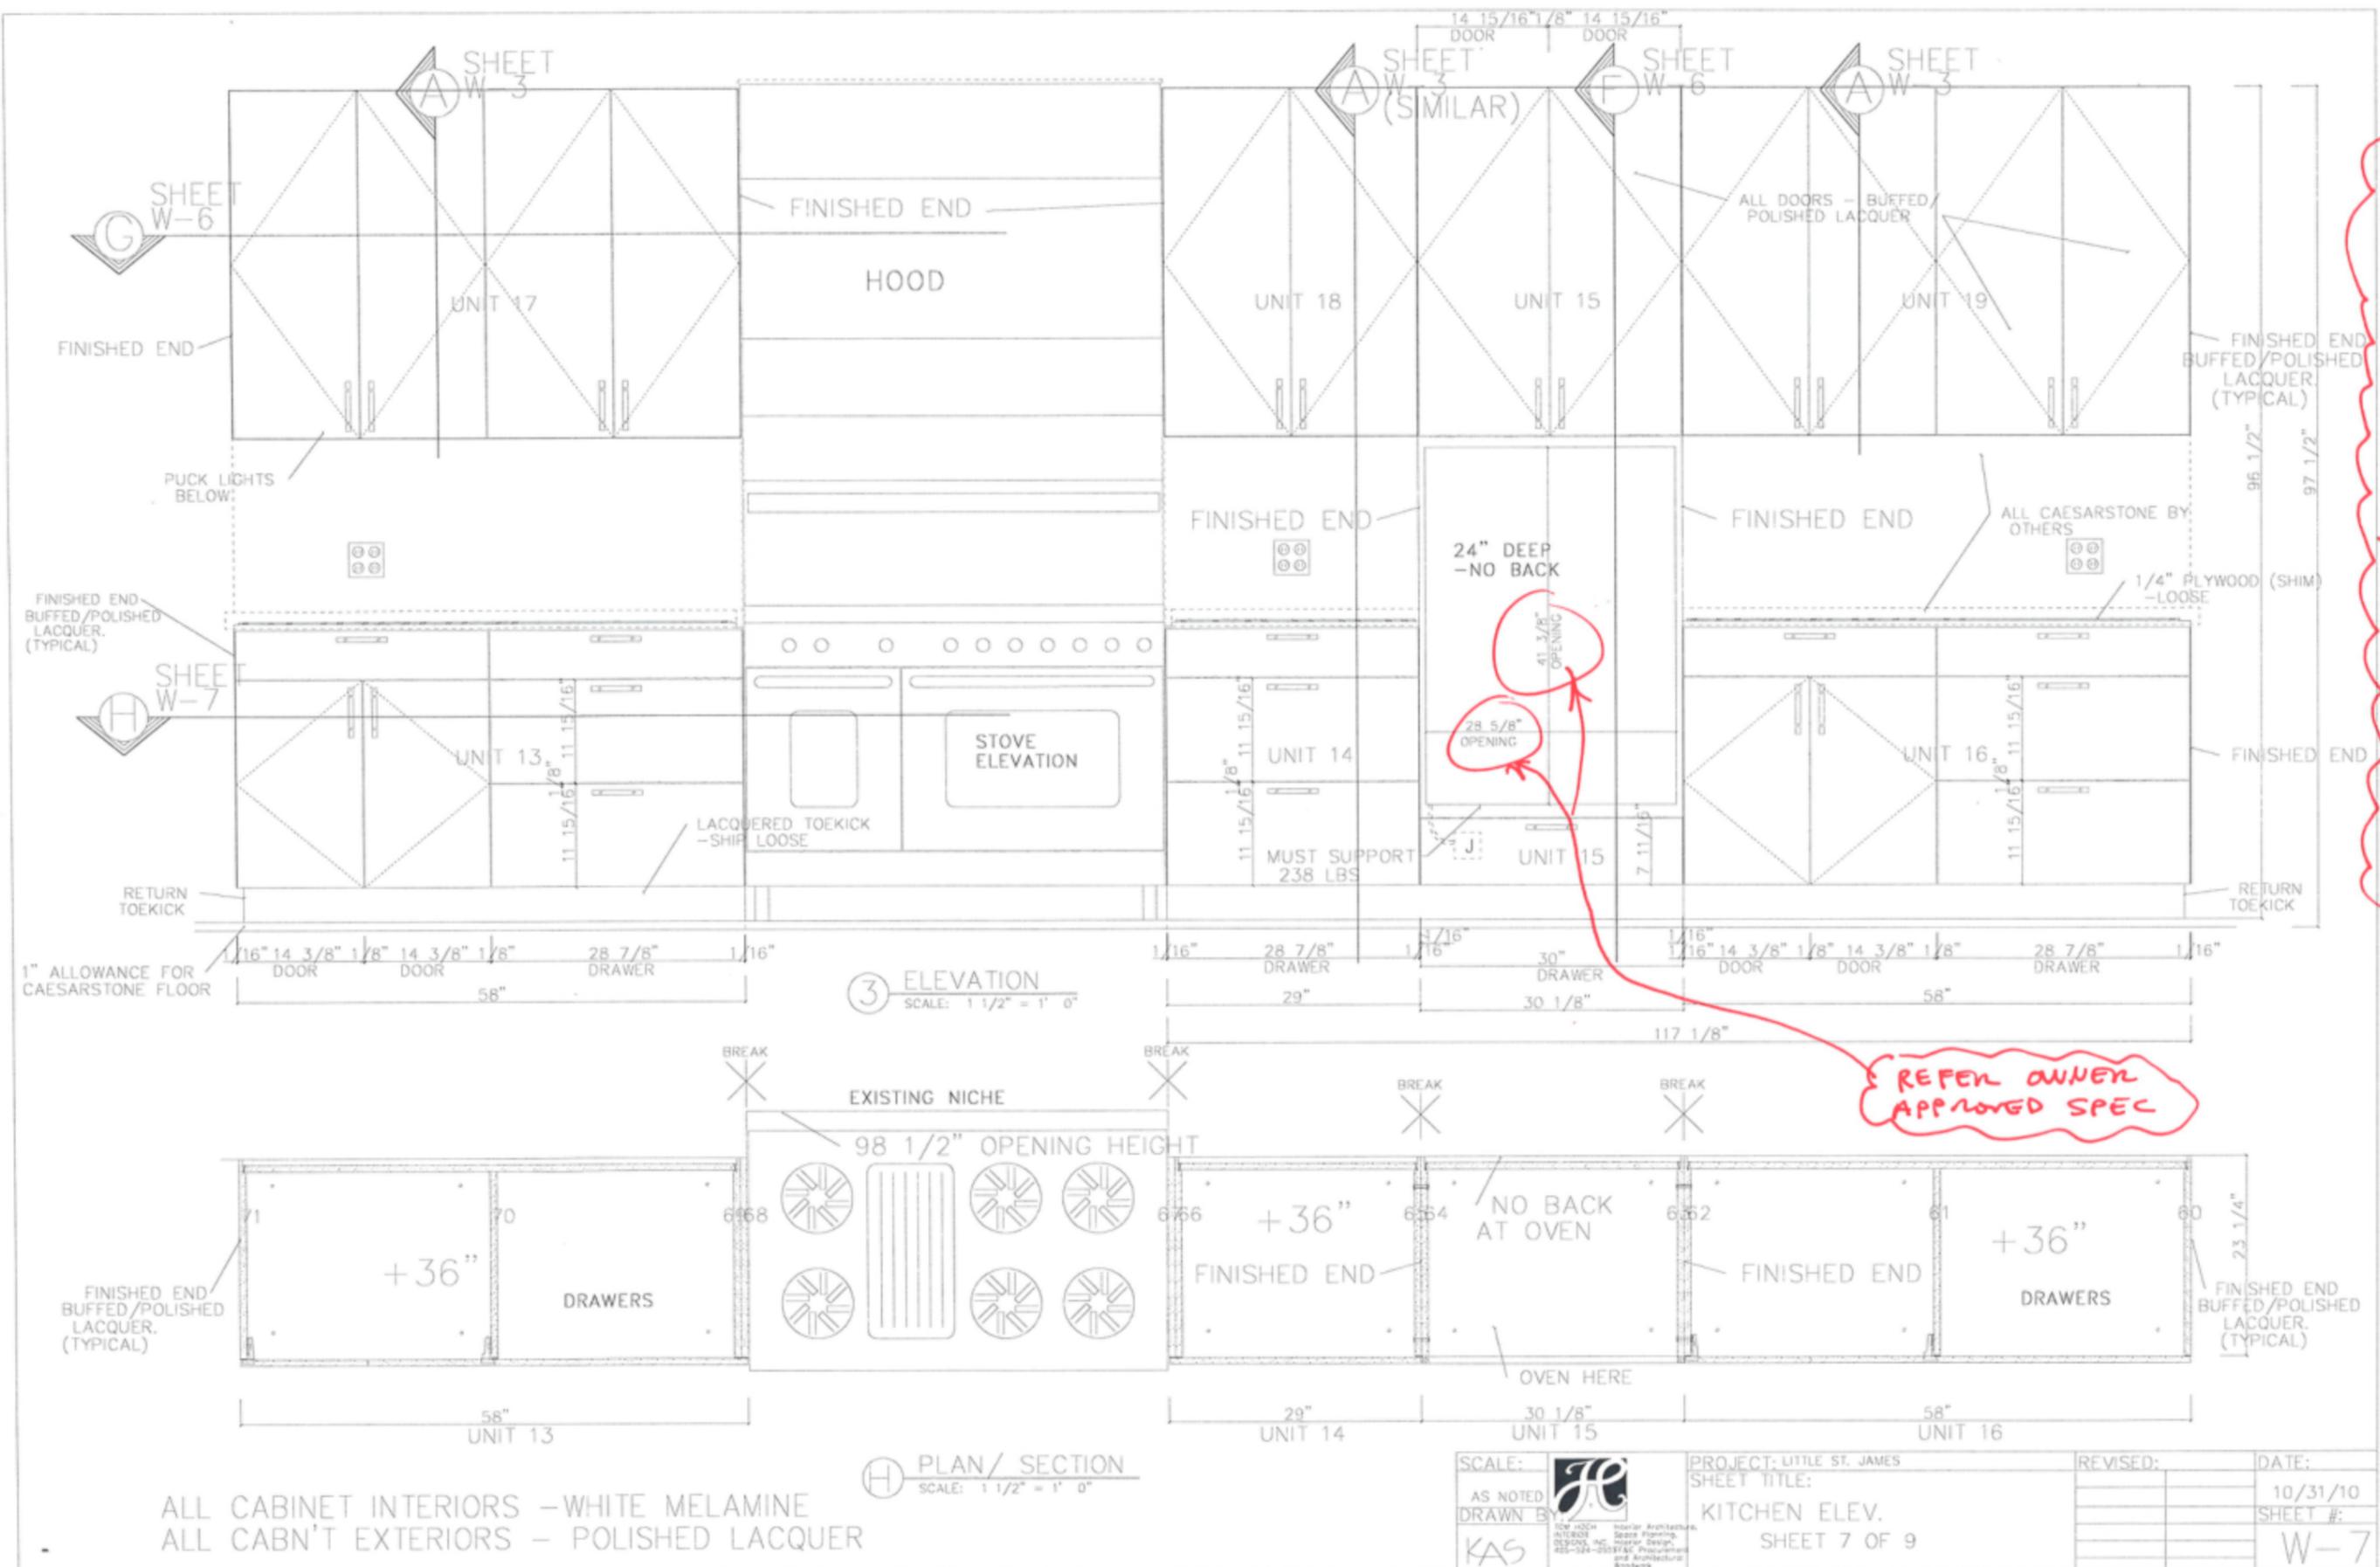


PROVIDE DESIGNER w/ FINISH SAMPLES FOR APPROVAL PRIOR TO FABRICATION.
OWNER TO APPROVE ALL APPLIANCES

REFER OWNER APPROVED SPEC


K. APPROVED 11.10.2010
MANK ZEFF.

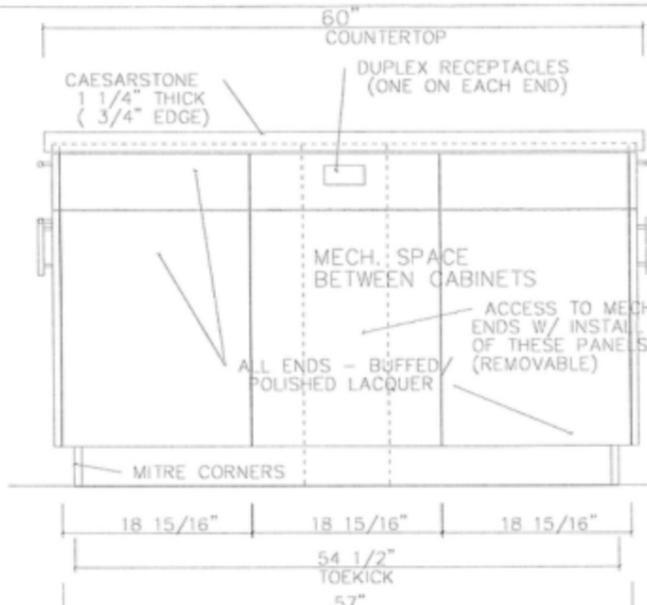

5 ELEVATION
SCALE: 1 1/2" = 1' 0"

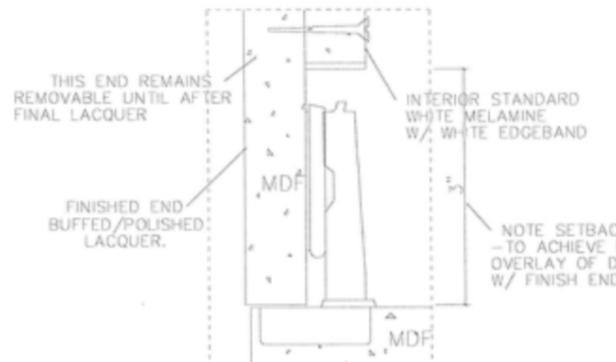


EE DETAIL
SCALE: FULL SIZE

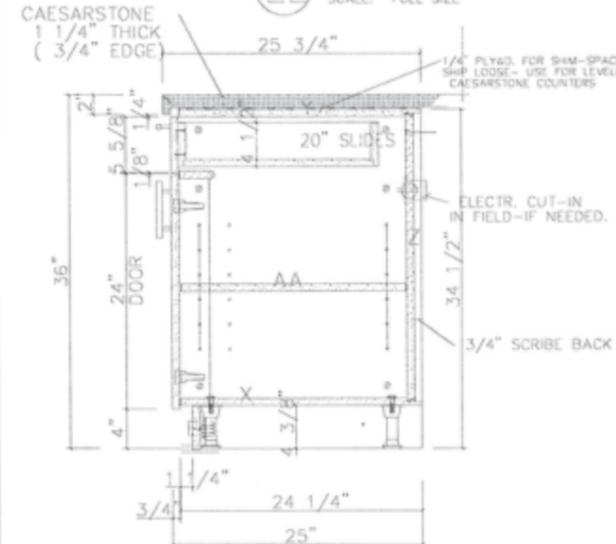


J SECTION
SCALE: 1 1/2" = 1' 0"

ALL CABINET INTERIORS - WHITE MELAMINE
ALL CABN'T EXTERIORS - POLISHED LACQUER

NOTE -
WILL ISLAND BE OK 11 1/4" LONGER?
DOUBLE WASTE BIN SOFT-CLOSE GLIDES
REQUIRE MINIMUM 15 1/4" OPENING.

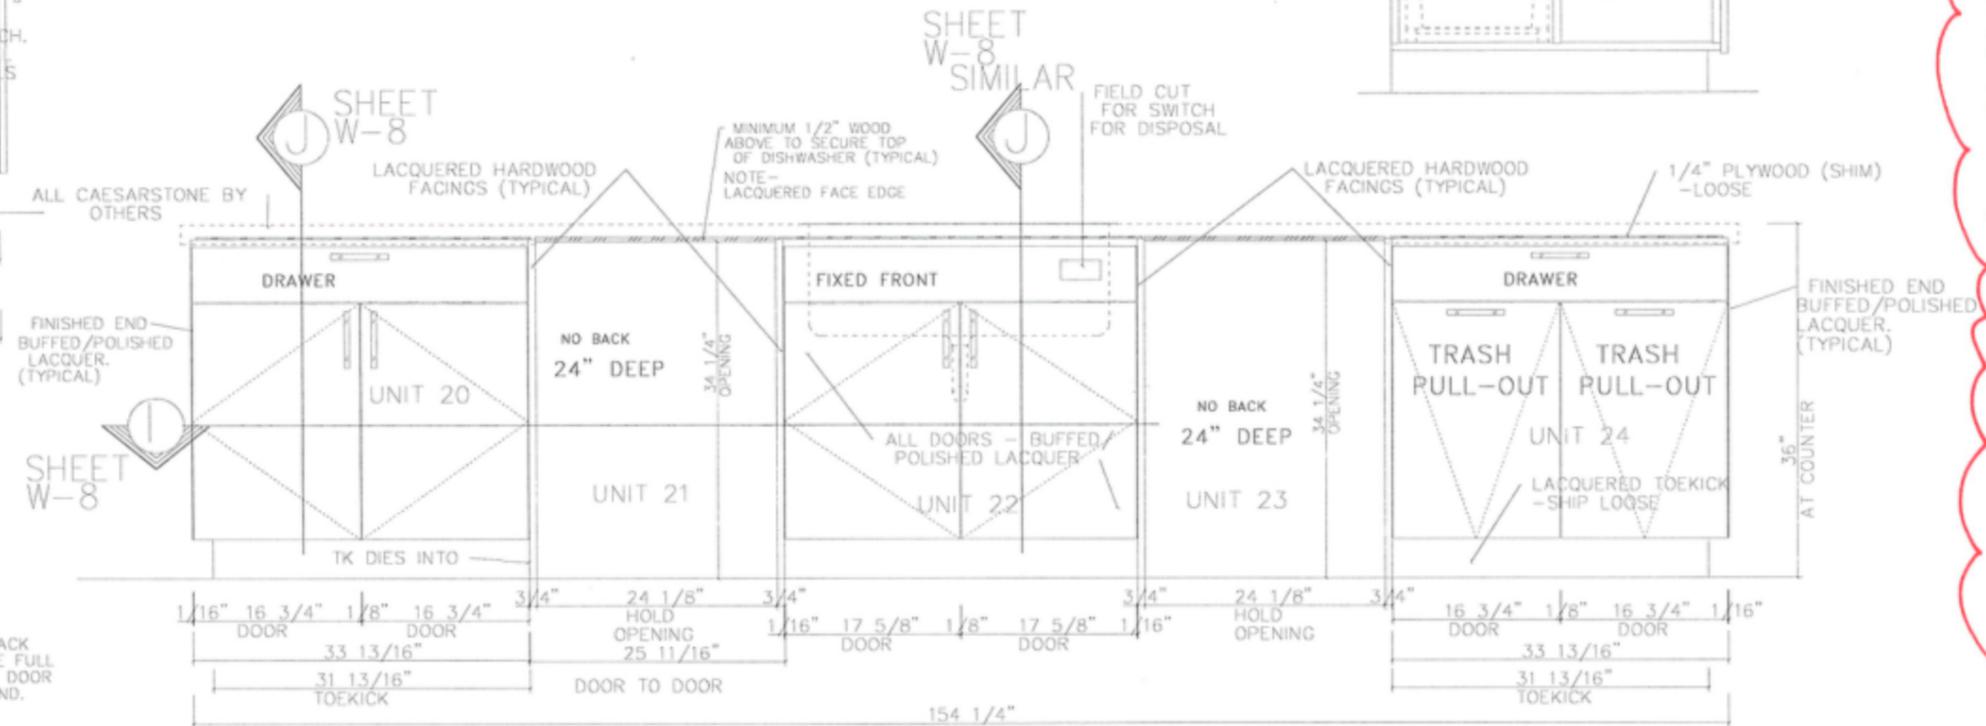

4 ELEVATION
SCALE: 1 1/2" = 1' 0"

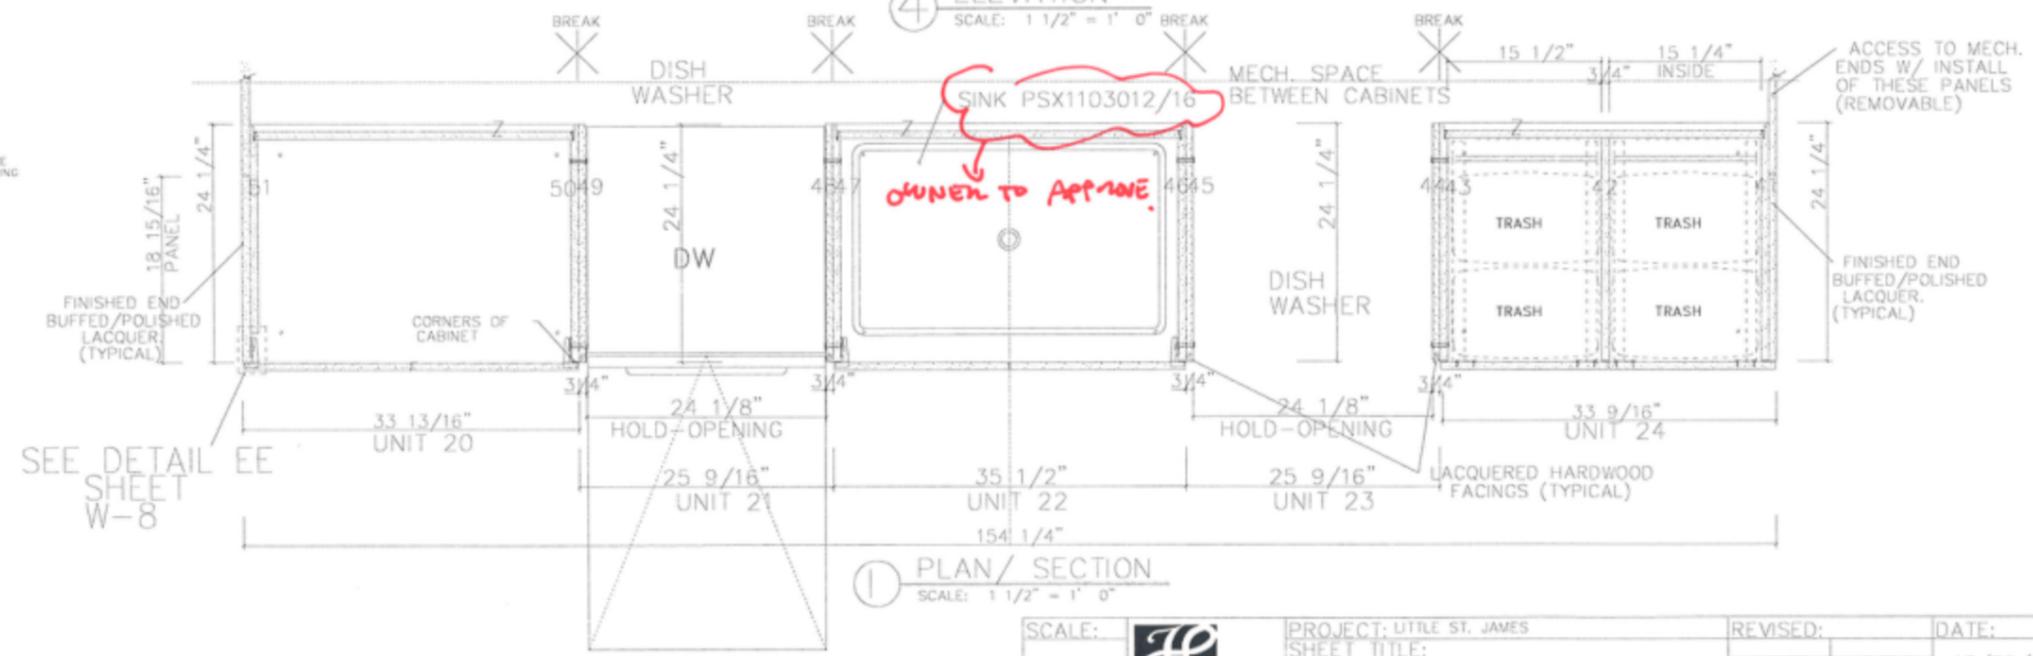


1 PLAN / SECTION
SCALE: 1 1/2" = 1' 0"


PROVIDE DESIGNER W/ FINISH SAMPLES
FOR APPROVAL PRIOR TO FABRICATION
OWNER TO APPROVE PLUMBING SPEC.

APPROVED 10.11.2010
MAMK ZEFF


SCALE: AS NOTED DRAWN BY KAS		PROJECT: UTILE ST. JAMES SHEET TITLE: ISLAND ELEV./SECTION SHEET 8 OF 9	REVISED:	DATE: 10/25/10 SHEET #: W-8
---------------------------------------	--	----------------------------------------------------------------------------------	----------	--------------------------------------

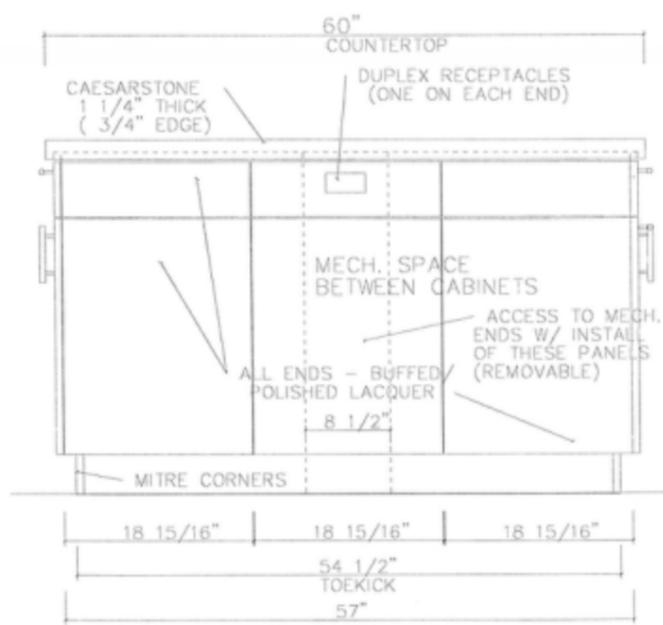


5 ELEVATION
SCALE: 1 1/2" = 1' 0"

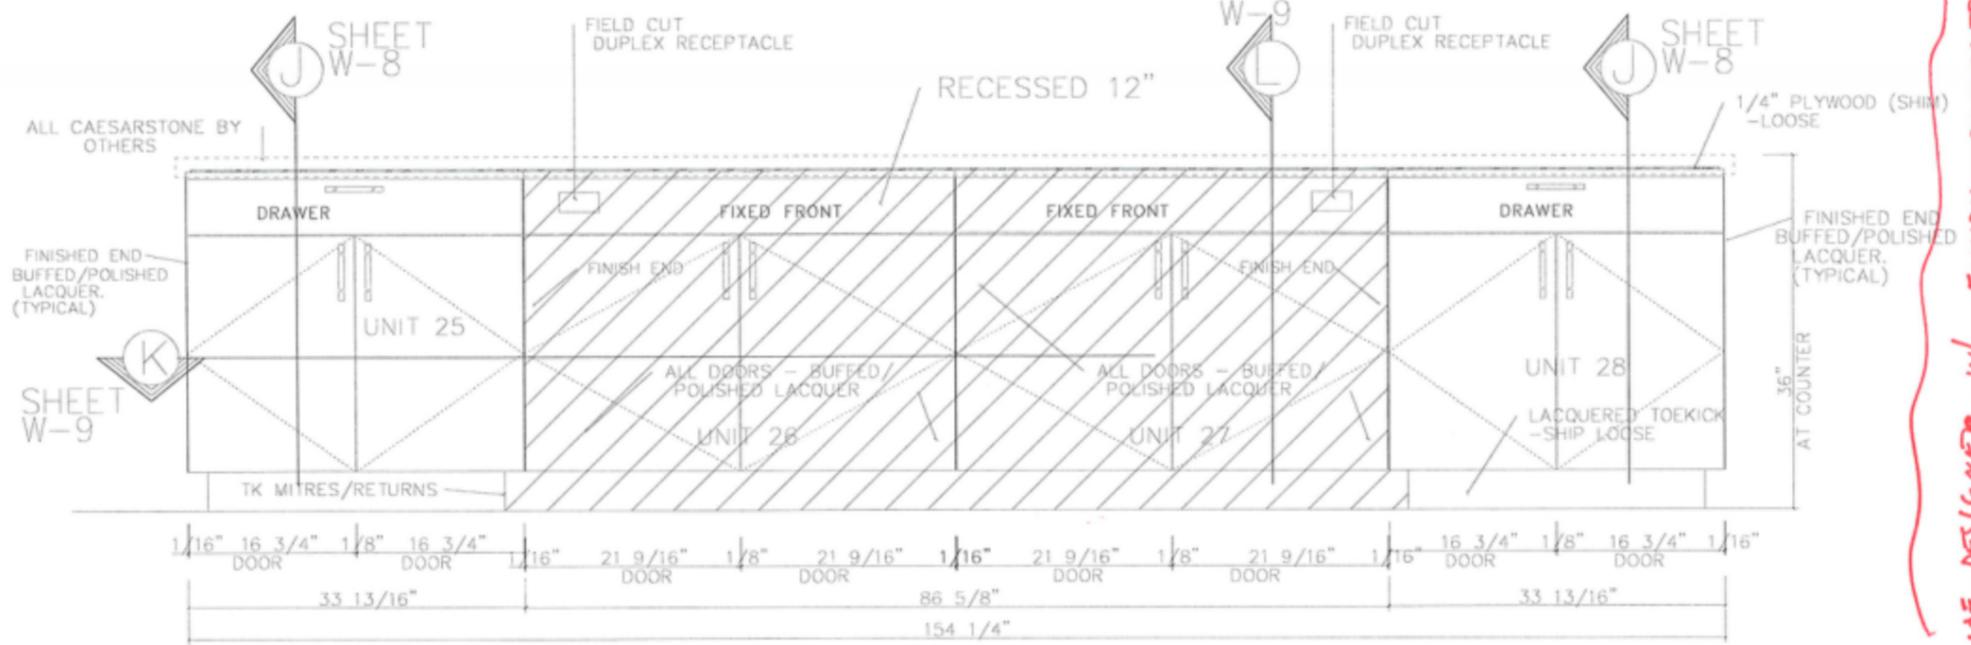

6 ELEVATION
SCALE: 1 1/2" = 1' 0"

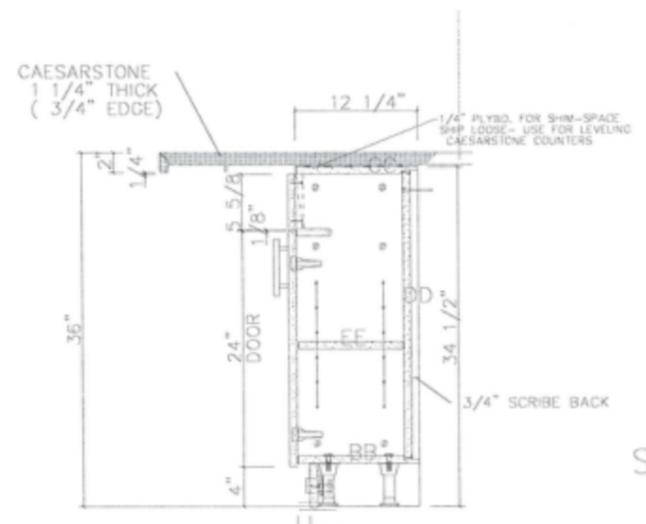

SECTION
SCALE: 1 1/2" = 1' 0"

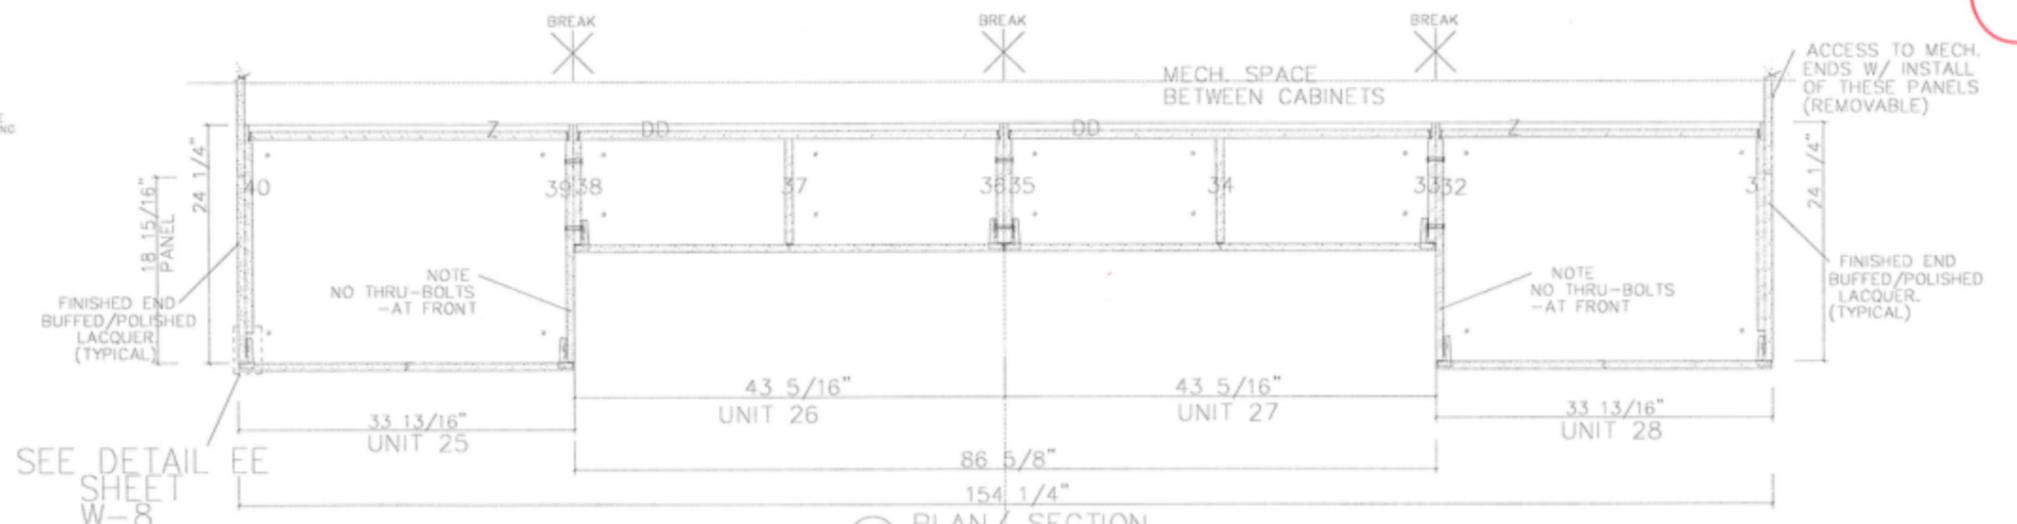

K PLAN/SECTION
SCALE: 1 1/2" = 1' 0"

NOTE - WILL ISLAND BE OK 11 1/4" LONGER? → DESIGNER APPROVED CONFIRM W/ OWNER.

ALL CABINET INTERIORS - WHITE MELAMINE
ALL CABN'T EXTERIORS - POLISHED LACQUER

SCALE: AS NOTED DRAWN BY: KAS		PROJECT: LITTLE ST. JAMES SHEET TITLE: ISLAND ELEV./SECTION SHEET 9 OF 9	REVISED:	DATE: 10/25/10 SHEET #: W-9
----------------------------------------	--	-----------------------------------------------------------------------------------	----------	--------------------------------------

PROVIDE DESIGNER W/ FINISH SAMPLES.
 FOR APPROVAL - PRIOR TO CONSTRUCTION.
 OWNER TO APPROVE SIZE INCREASE
 OF ISLAND.
 X APPROVED AS NOTED 11.10.2010
 J.E. MARK ZEFF.