



Sketch Number - Option B Lower Level Mark-ups

Gensler

Project	Little St. James	Project Number	05.7112.000
Description	Lower Level / Pool Level	Issue/Rev	Issue for Review
Prepared by	Scale 1/16"=1'-0"	Date	December 14, 2010

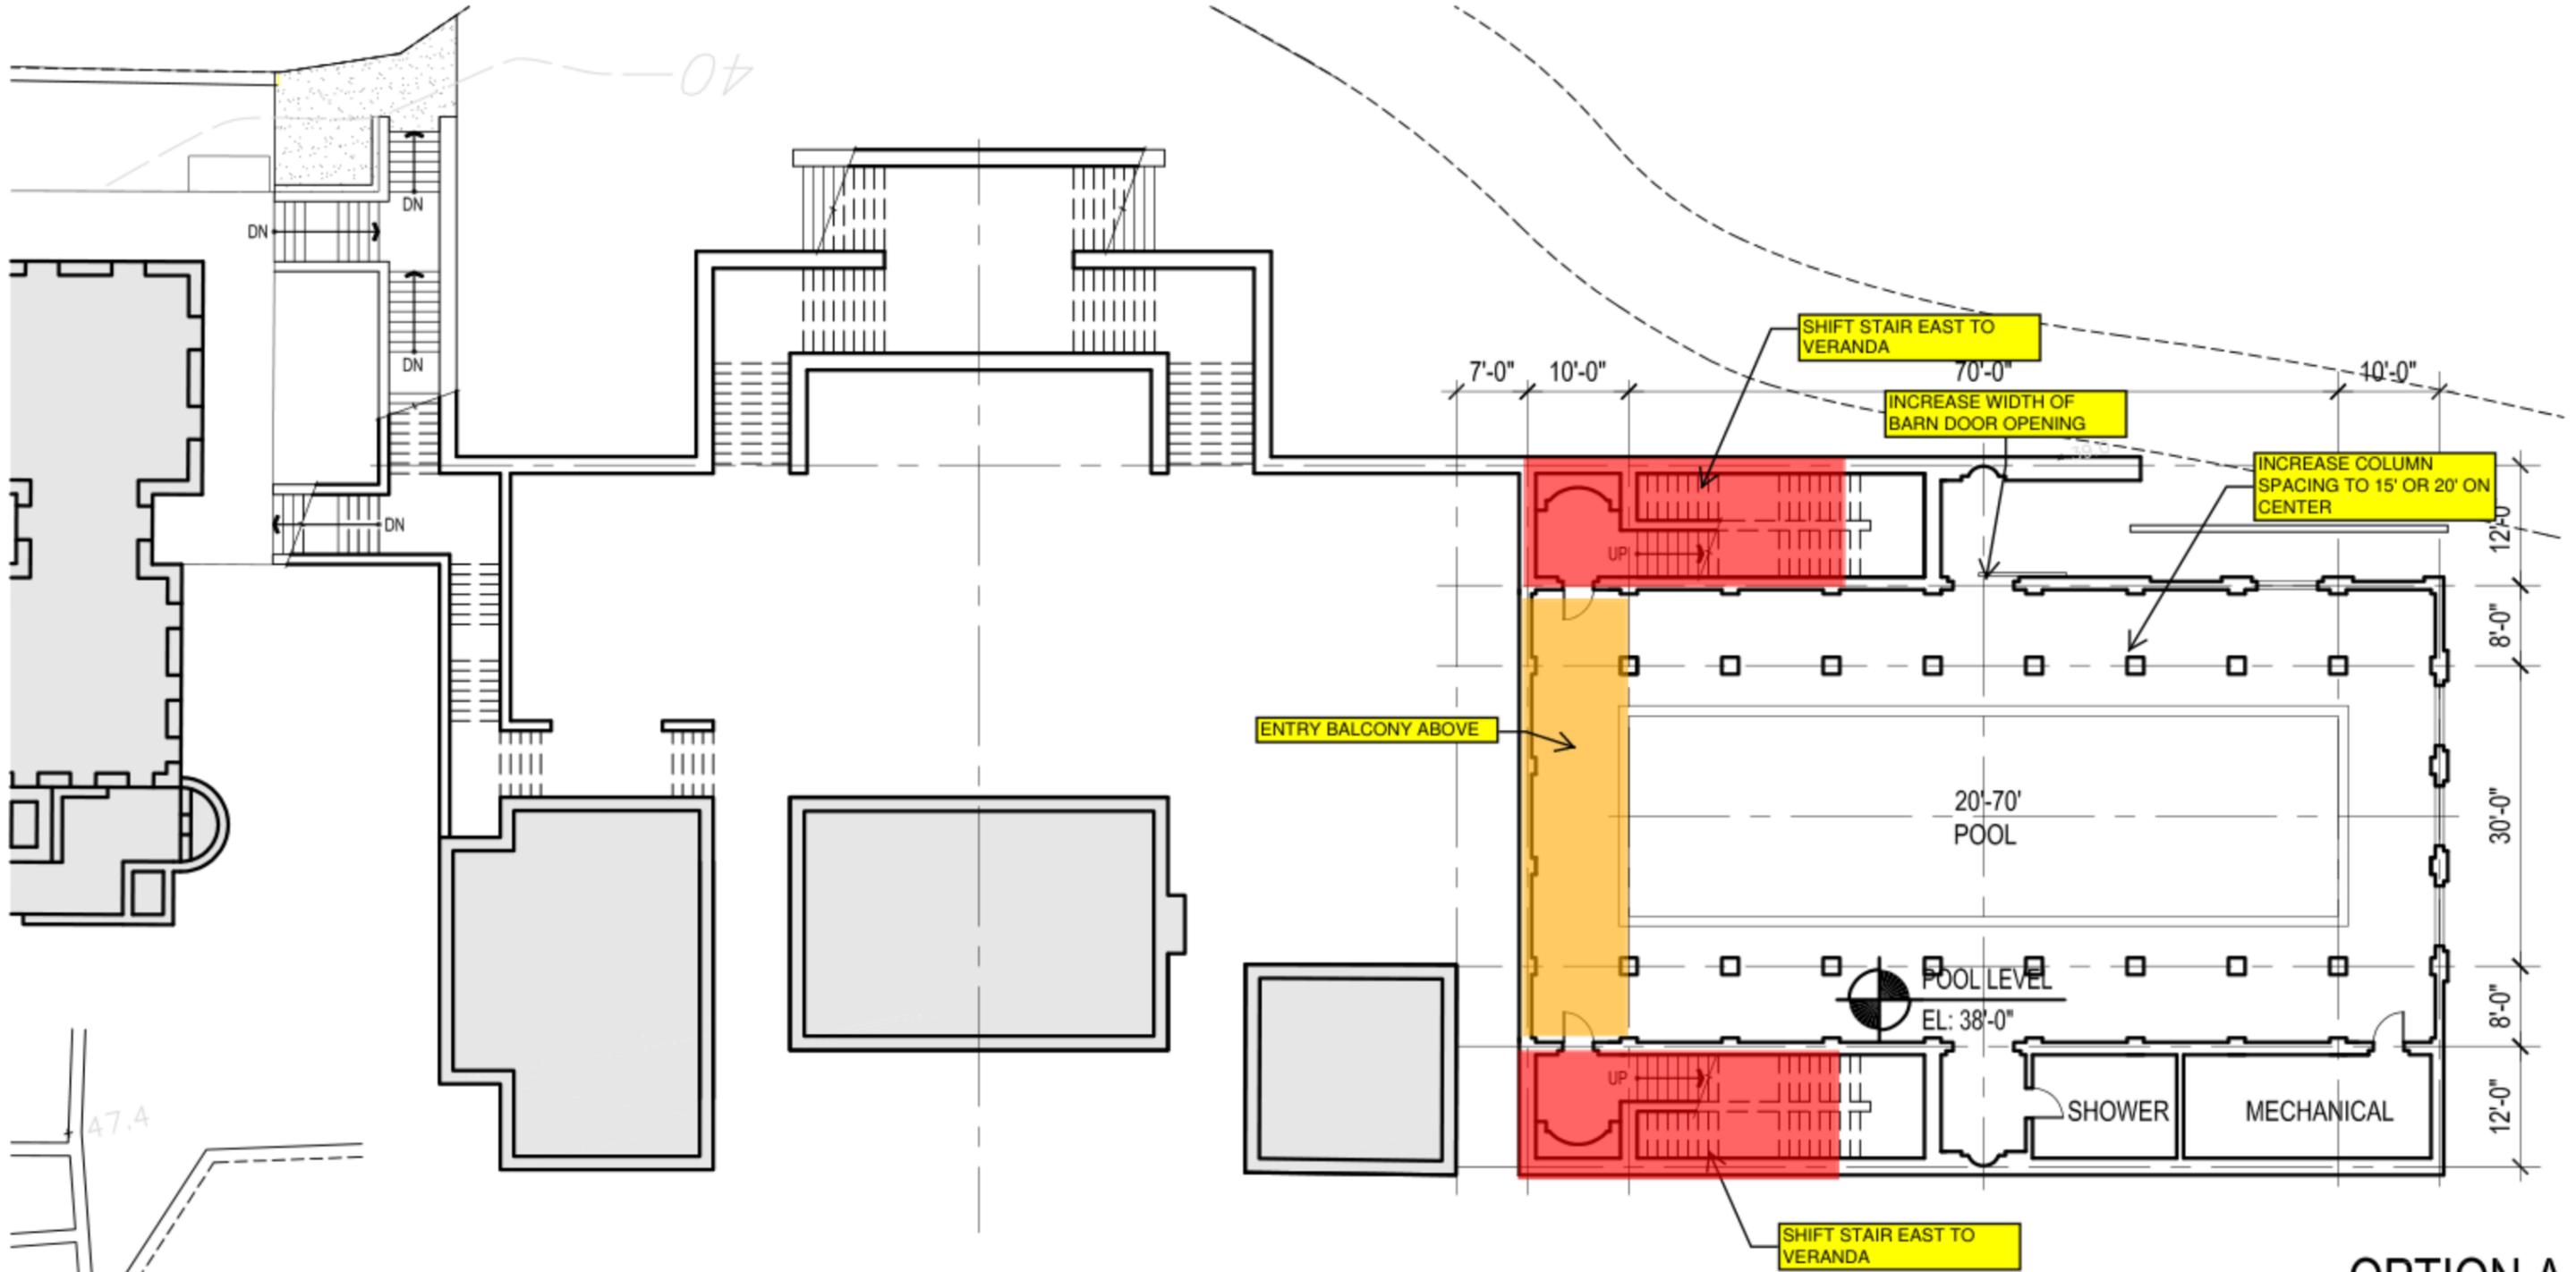

OPTION A

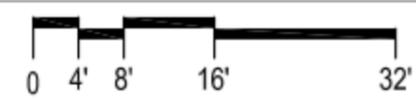

Santa Monica
 2500 Broadway
 Suite 300
 California 90404
 Tel: 310.449.5600
 Fax: 310.449.5850