


Dillsbury Sound

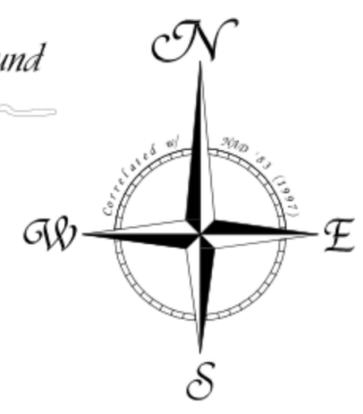

SHORELINE (SEE NOTE)

Parcel No. "C"
11.8 Acres ±
(D9-80.21-T007)


Contour Circa 2005

- UNMARKED POINT
- FINISH FLOOR ELEVATION

REFERENCE
D9-80.21-T007

ZONING
R-1

NOTES:
1. SHORELINE LOCATION IS BASED PARTLY UPON AERIAL PHOTOGRAMMETRIC MAPPING BY MARK HURD AERIAL SURVEYS, CIRCA 1971, AND PARTLY UPON CONVENTIONAL SURVEY METHODS, CIRCA 2005.
2. CONTOURS TAKEN FROM 2005 SURVEY AND HAVE NOT BEEN FIELD-CHECKED.

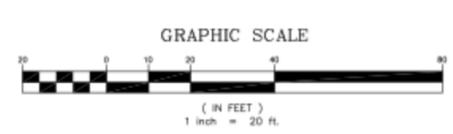

	Brian Moseley Associates, Inc. Land Surveyors & Consultants	4003 RAFFAELINE HILL ROAD SUITE 606 ST. THOMAS, VI 00802 PHONE (340) 774-5310 FAX (340) 776-4090
	<i>Partial As-built Survey of</i> Parcel No. "C" Little St. James Island No. 6A Red Hook Quarter St. Thomas, U.S. Virgin Islands	
SURVEY: CALC: R.C.W. DRAWN: R.C.W./D.J.S. SCALE: 1" = 20'	DATE: 8-27-2010 APPROVED:	DWG No: 1660-13B OLG FILE NO.